


APPLICATION FOR TRANSFER CHANGE IN USE AND PLACE OF USE

PERMIT 14200

CERTIFICATE 30441

TOWNSHIP 33 SOUTH RANGE 2 EAST, W.M.

JACKSON COUNTY

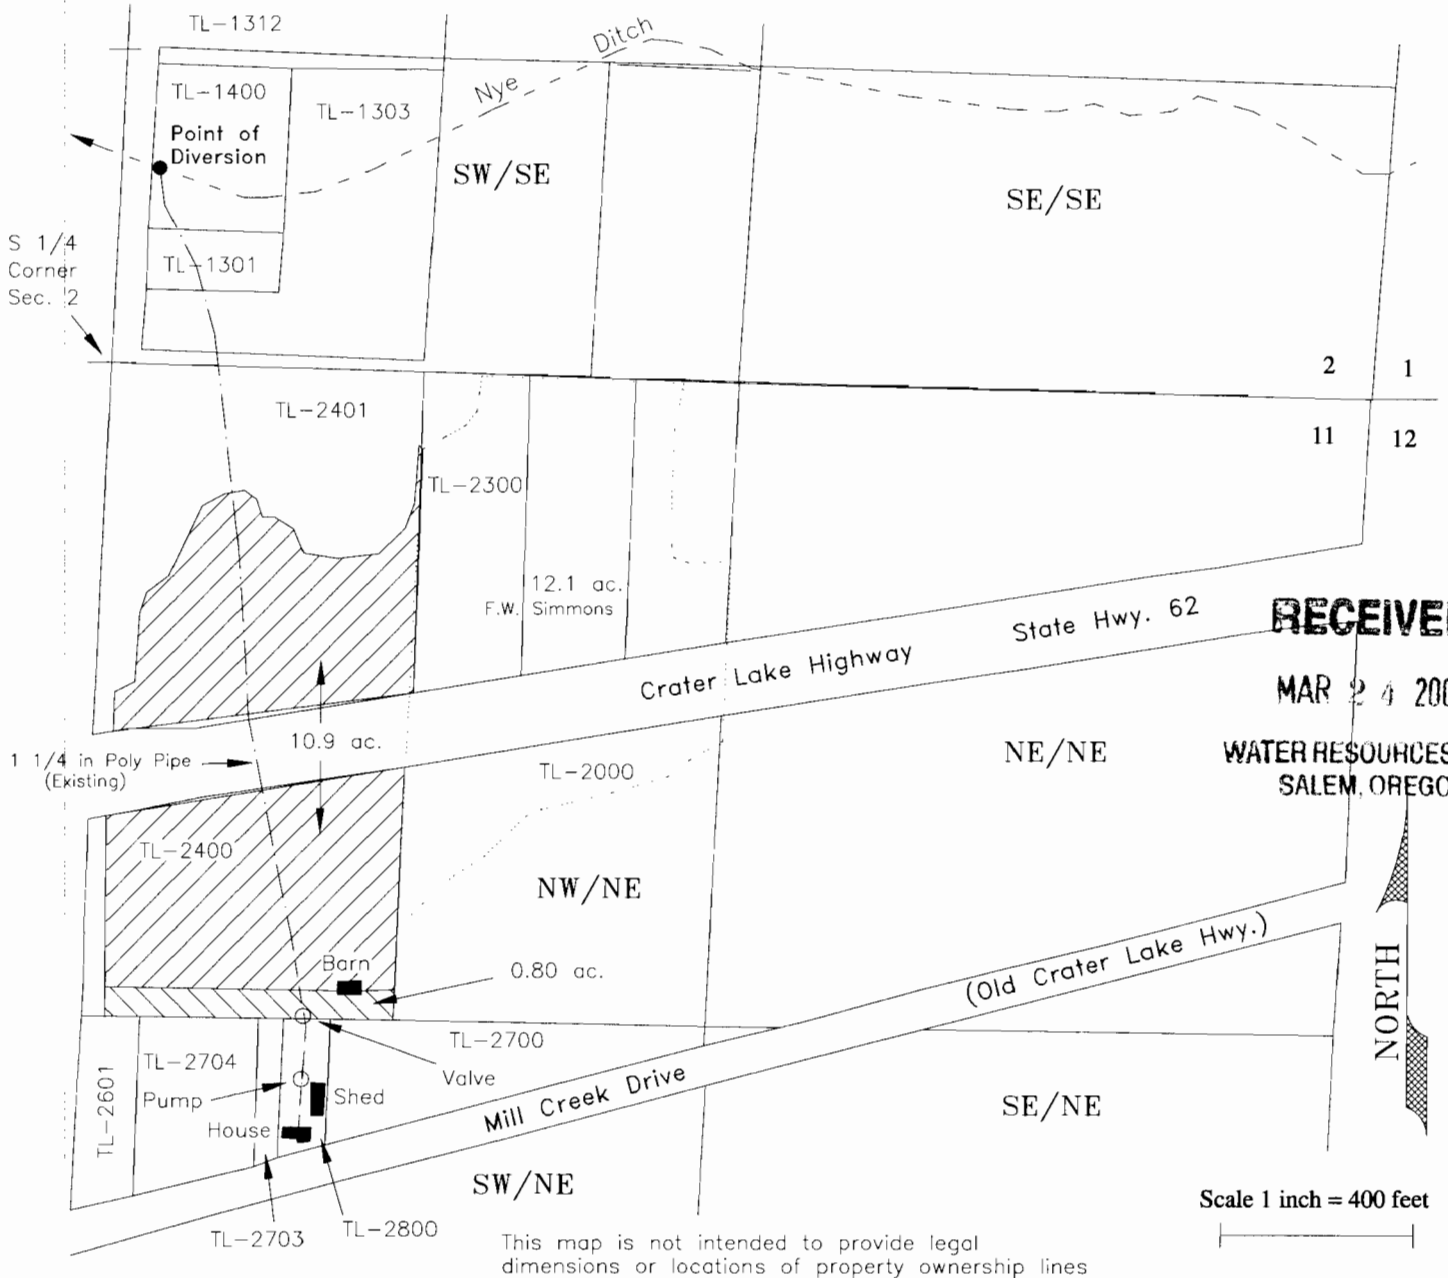

This map is not intended to provide legal dimensions or locations of property ownership lines

Point of Diversion - Mill Creek - NW/SE, Section 28, T.32S, R.3E., W.M. (No Change)

- Point of Diversion - Nye Ditch - SW/SE, Section 2, T.33S, R.2E., W.M.
410 ft. North & 80 ft. East from the S1/4 Corner Section 2 (No Change)

- Remaining Right - 10.9 acres
- FROM land - 0.8 acre Irrigation to Domestic Use
SW/NE Section 11, T.33S, R.2E., W.M.


Applicant: Mary Lou King
1700 Branta Road
Juneau, AK 99801

Revised
2/7/2008 n.e.d.



Public Works Management, Inc.
171 South Second Street
Central Point, OR 97502
(541) 665-5233
FAX: (541) 665-5266

T.33S.R.2E.W.M.

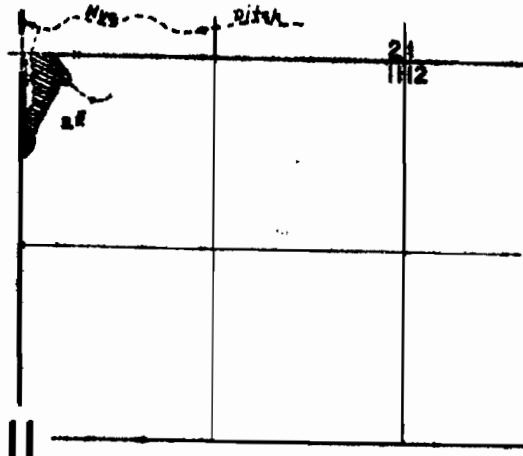

FINAL PROOF SURVEY UNDER

Transfer No. N-26
 Application No. _____ Permit No. 14200
 IN NAME OF

David Neville

Surveyed March 8, 1969, by D.G. Hendrix