


AUG - 2 1996

WATER RESOURCES DEPT.

NE CORNER SEC. 4
T.3 N., R.34 E., W.M.

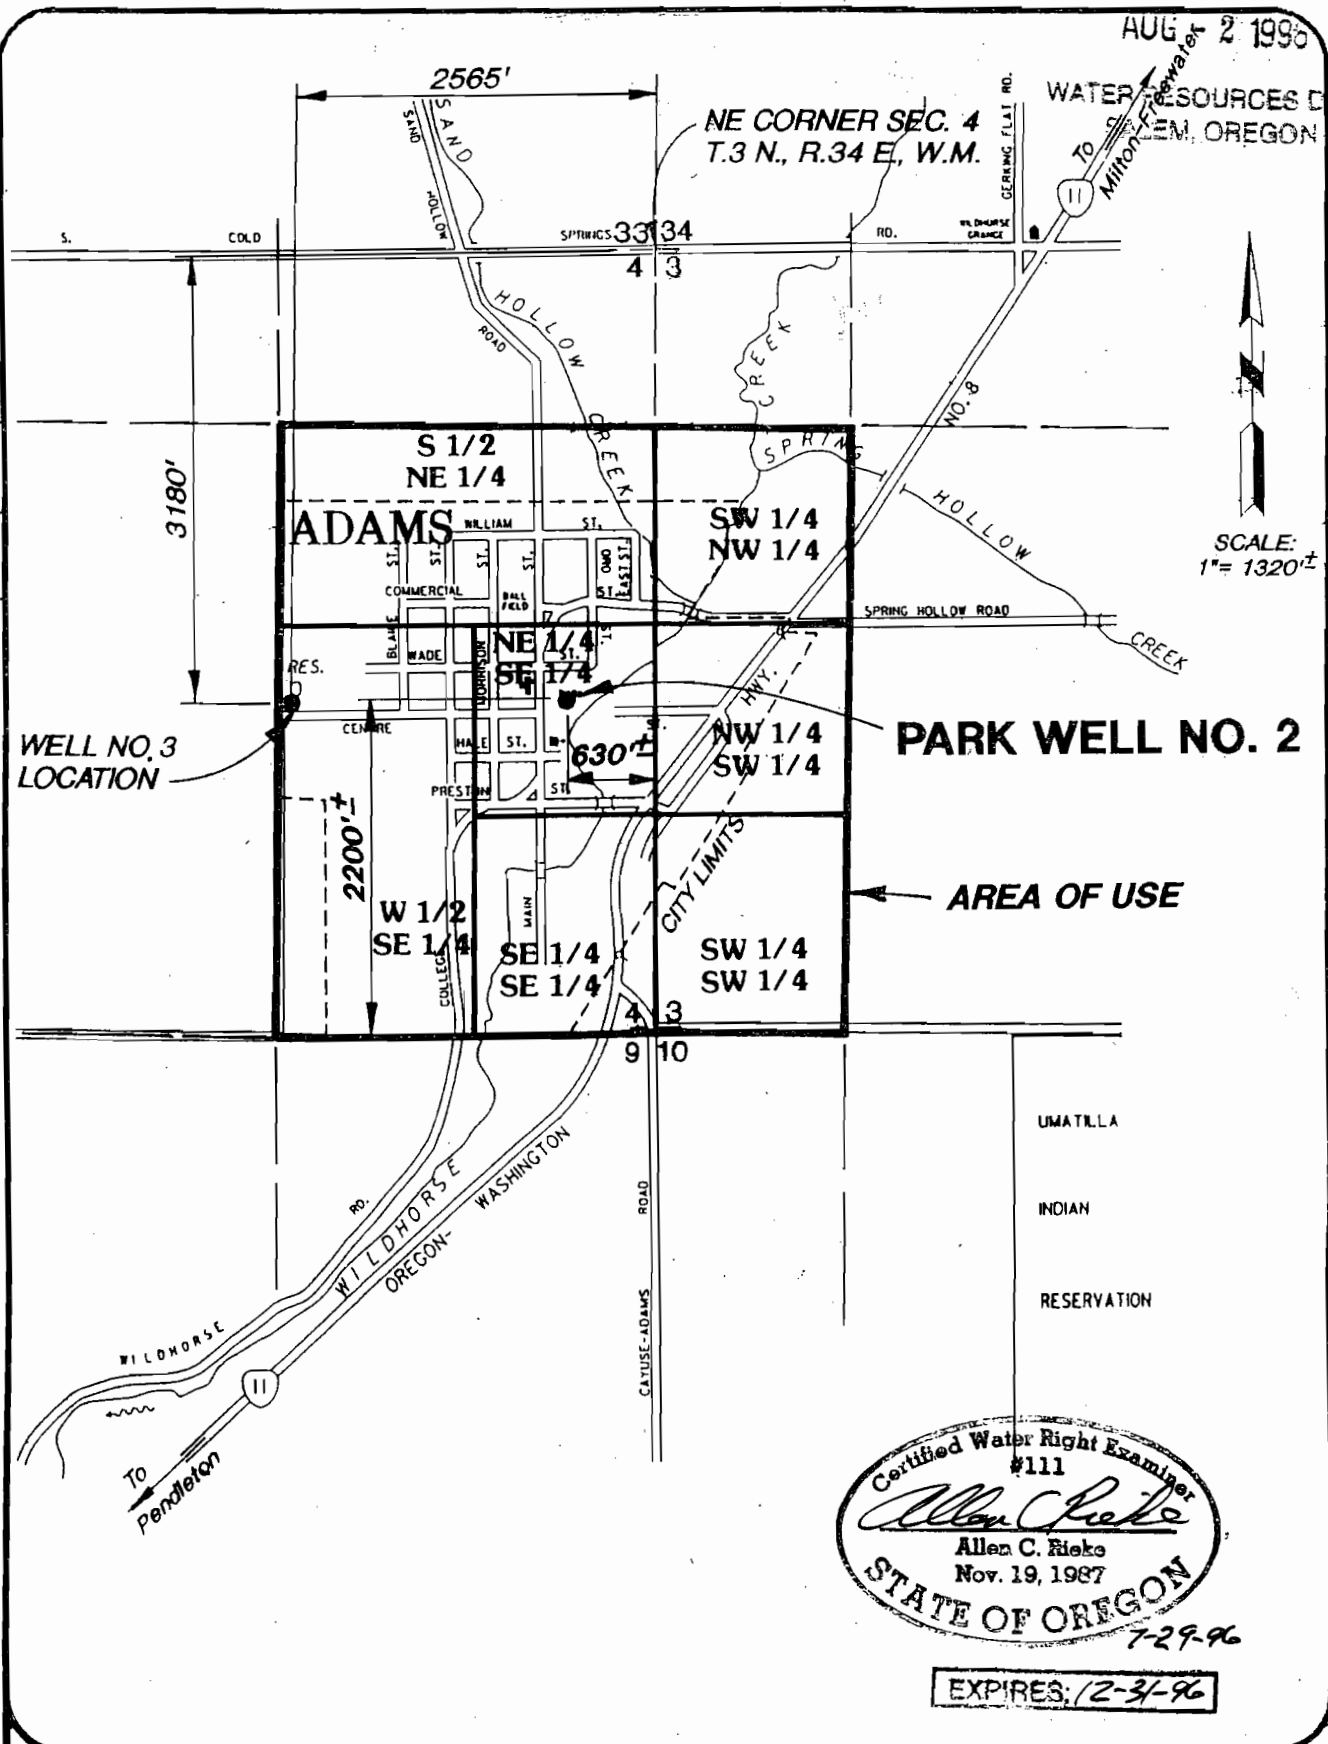

PARK WELL NO. 2

AREA OF USE

UMATILLA
INDIAN
RESERVATION

Certified Water Right Examiner
#111
Allen C. Rieko
Allen C. Rieko
Nov. 19, 1987
STATE OF OREGON

7-29-96

EXPIRES: 12-31-96