


RECEIVED

AUG 2 1996

WATER RESOURCES DEPT.

NE CORNER SEC. 4
T.3 N., R.34 E., W.M.

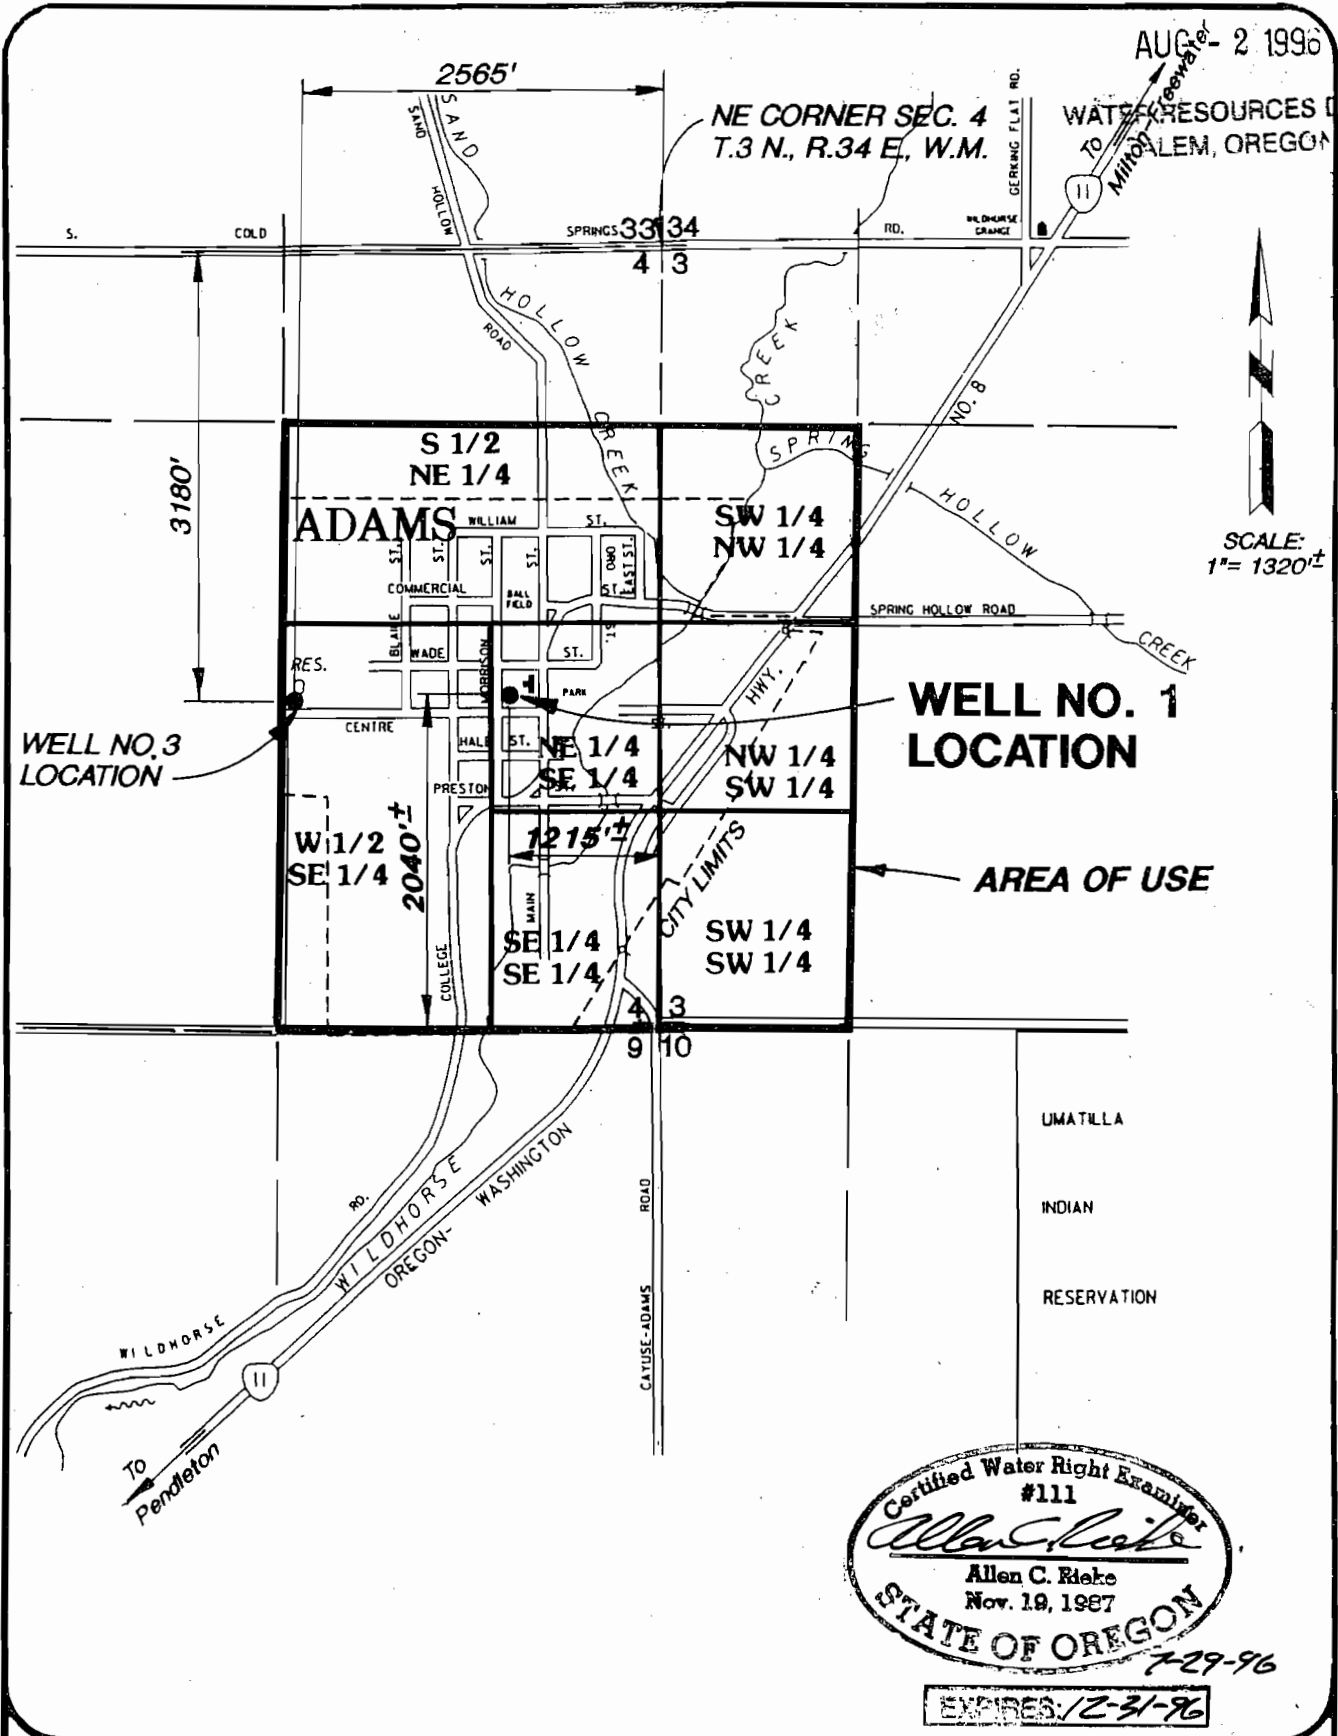

ap anderson
perry
& associates, inc.

CITY OF
ADAMS, OREGON
FINAL PROOF SURVEY MAP
TRANSFER NO. T-6593
PERMIT NO. U-596

Certified Water Right Examiner
#111
Allen C. Rieke
Allen C. Rieke
Nov. 19, 1987
STATE OF OREGON

EXPIRES 12-31-96