

Polk County Map

8.6.12 Parcel 500

Roads

Taxlot10

Taxlot Arrows10

Taxlot Boundary6

TaxMap

26

32

34

TaxMap Sub Line

TaxMapAr



RECEIVED  
MAY 14 2010  
WATER RESOURCES DEPT  
GENERAL OFFICE

PP 200

Special 511' from SW marsh corner

Lat: 44 53 04.078 Long: 123 22 35.449  
28 acres



Special runoff

S15°34'45"W298.93


N89°36'42"E

429.82

10.9 ft

This map was produced using the Polk County GIS data. The GIS data is maintained by the county to support its governmental activities. The county is not responsible for map errors, omissions, misuse or misinterpretation.

1 in. = 80 ft.

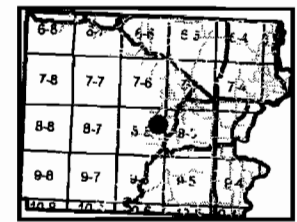

4/21/2010




Polk County Map

8.6.12 taxlot 500


- Contours
- Roads
- Taxlot 10
- Taxlot Arrows 10
- Taxlot Boundary 6 taxlot 10
- TaxMap
- 26
- 32
- 33
- 34
- TaxMap Sub Line
- TaxMap Ar

R-86094

R-14153

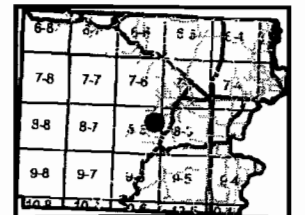

4/21/2010

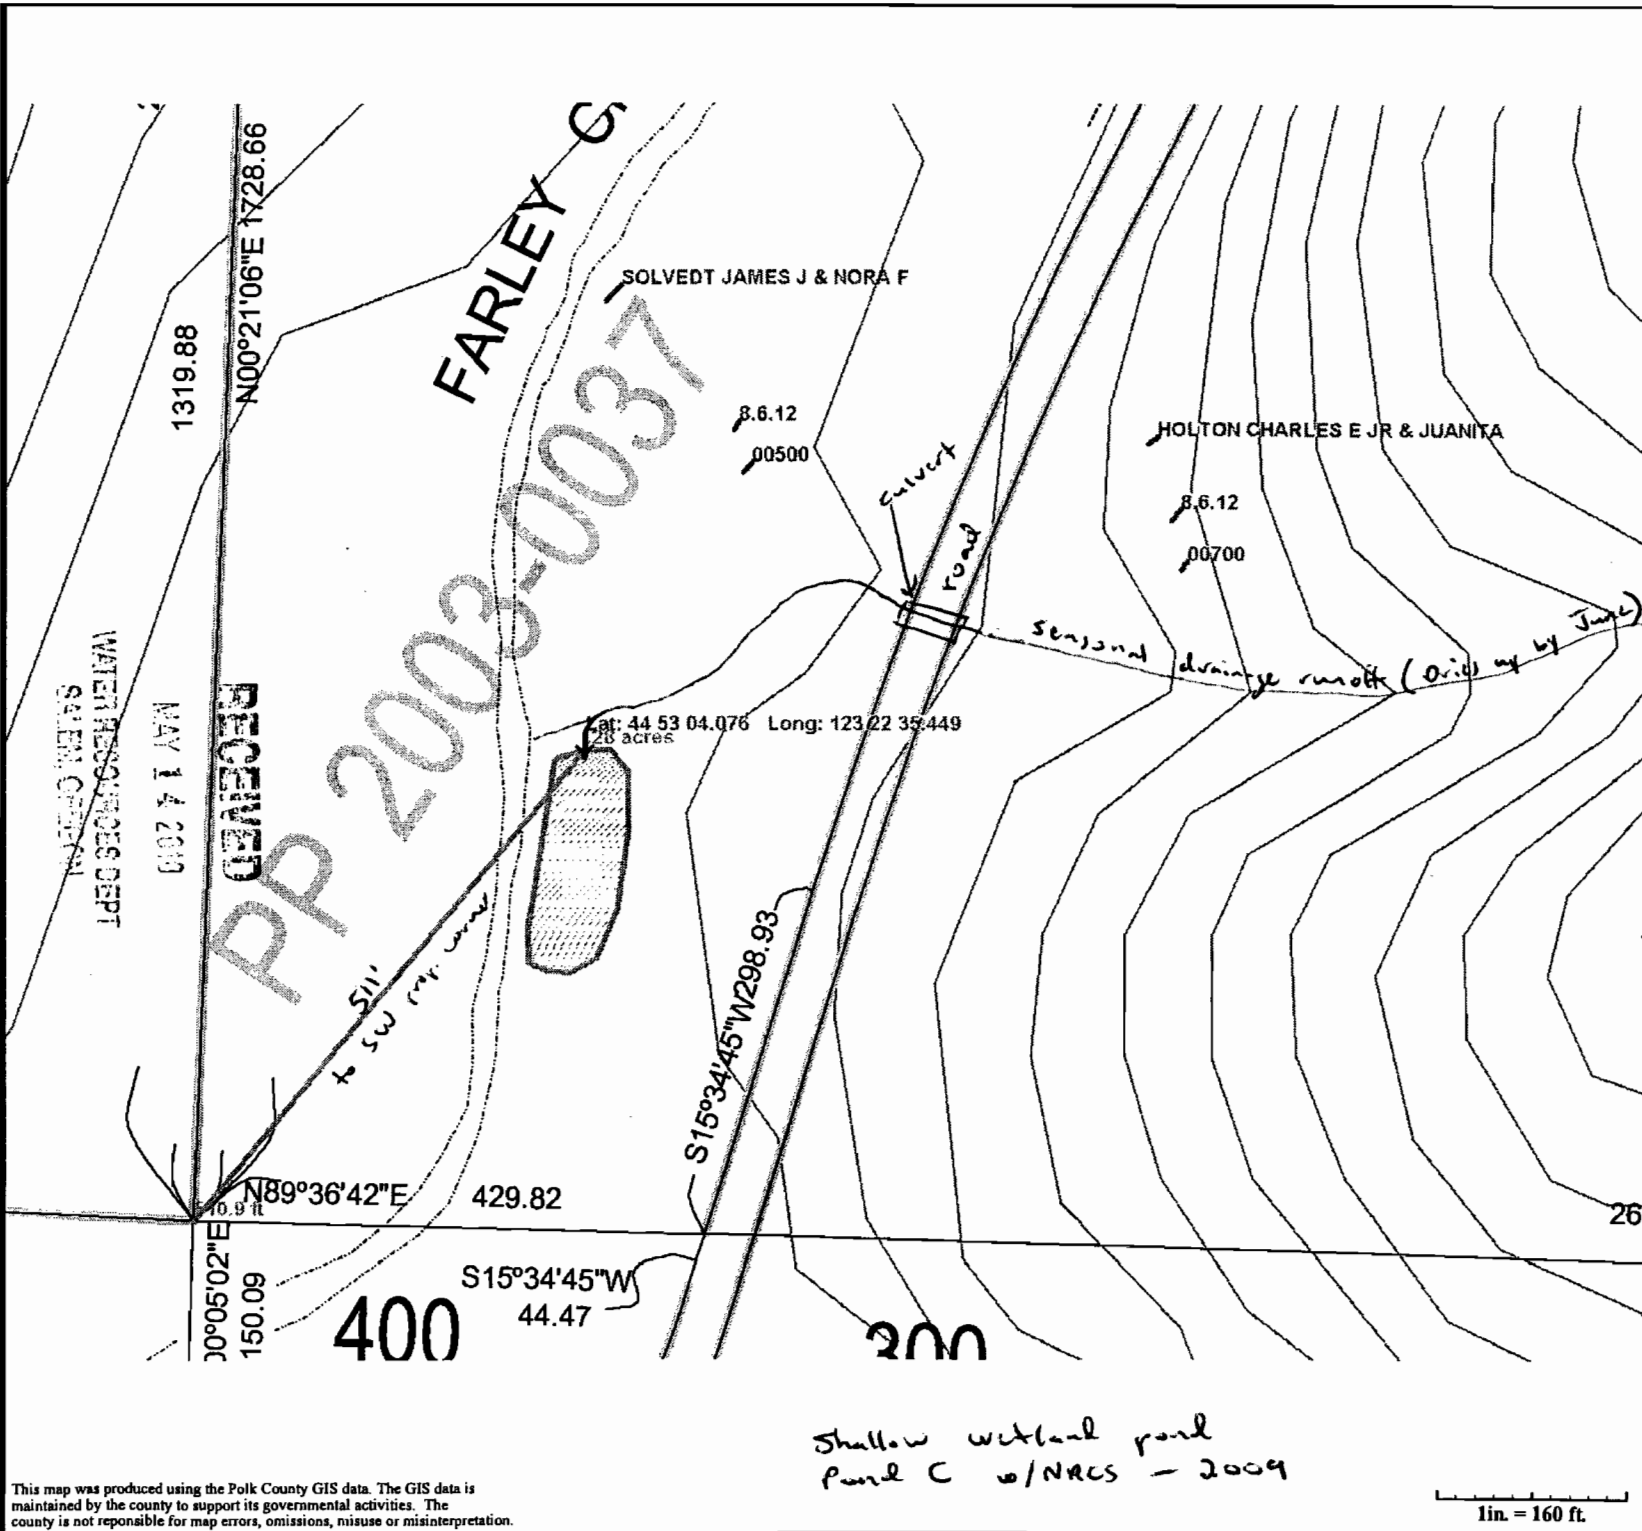

Shallow wetland pond  
Parcel C w/NRCS - 2009

1 in. = 160 ft.

This map was produced using the Polk County GIS data. The GIS data is maintained by the county to support its governmental activities. The county is not responsible for map errors, omissions, misuse or misinterpretation.

RECEIVED  
 MAY 14 2010  
 WATER RESOURCES DEPT  
 SALEM OFFICE

PP 2003-0037