


Polk County Map

8.6.12 taxlot 500

- Roads
- Taxlot10
- Taxlot Arrows10
- Taxlot Boundary6
- TaxMap
- 26
- 32
- 33
- 34
- TaxMap Sub Line
- TaxMapAr

Township 8  
 Range 6  
 Section 12  
 (taxlot 500)

Spring source  
 on T8, R6, S11  
 (taxlot 2000)

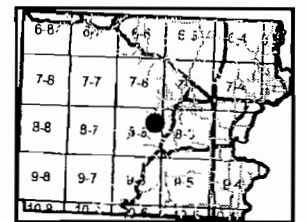

4/20/2010

UUU  
**PARCEL 2**  
**26.96 AC**

N00°18'


506.55

564°28'13"W

165.0 ft House

221.6 ft Barn

Spring (Piped to source)  
 (approx 320' to source)

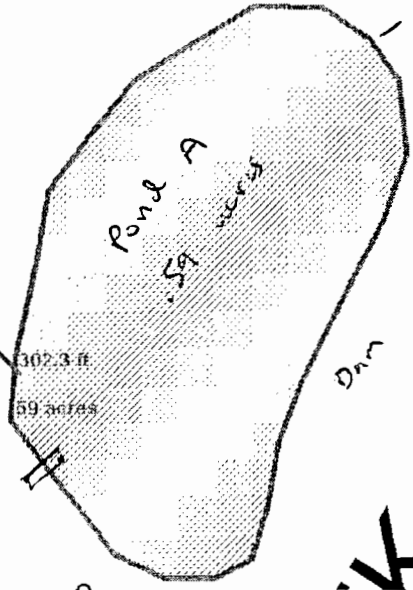

Fairley Creek

RECEIVED

MAY 14 2010

WATER RESOURCES DEPT  
 SALEM, OREGON

1 in. = 80 ft.

This map was produced using the Polk County GIS data. The GIS data is maintained by the county to support its governmental activities. The county is not responsible for map errors, omissions, misuse or misinterpretation.