

Polk County Map

8.6.12 taxlot 500



Roads  
 Taxlot10  
 Taxlot Arrows10  
 Taxlot Boundary6

R-36093  
 R-14157


RECEIVED

MAY 14 2010

WATER RESOURCES DEPT  
 SALEM, OREGON

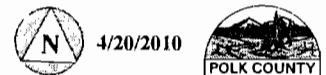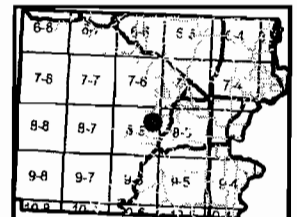

4/20/2010

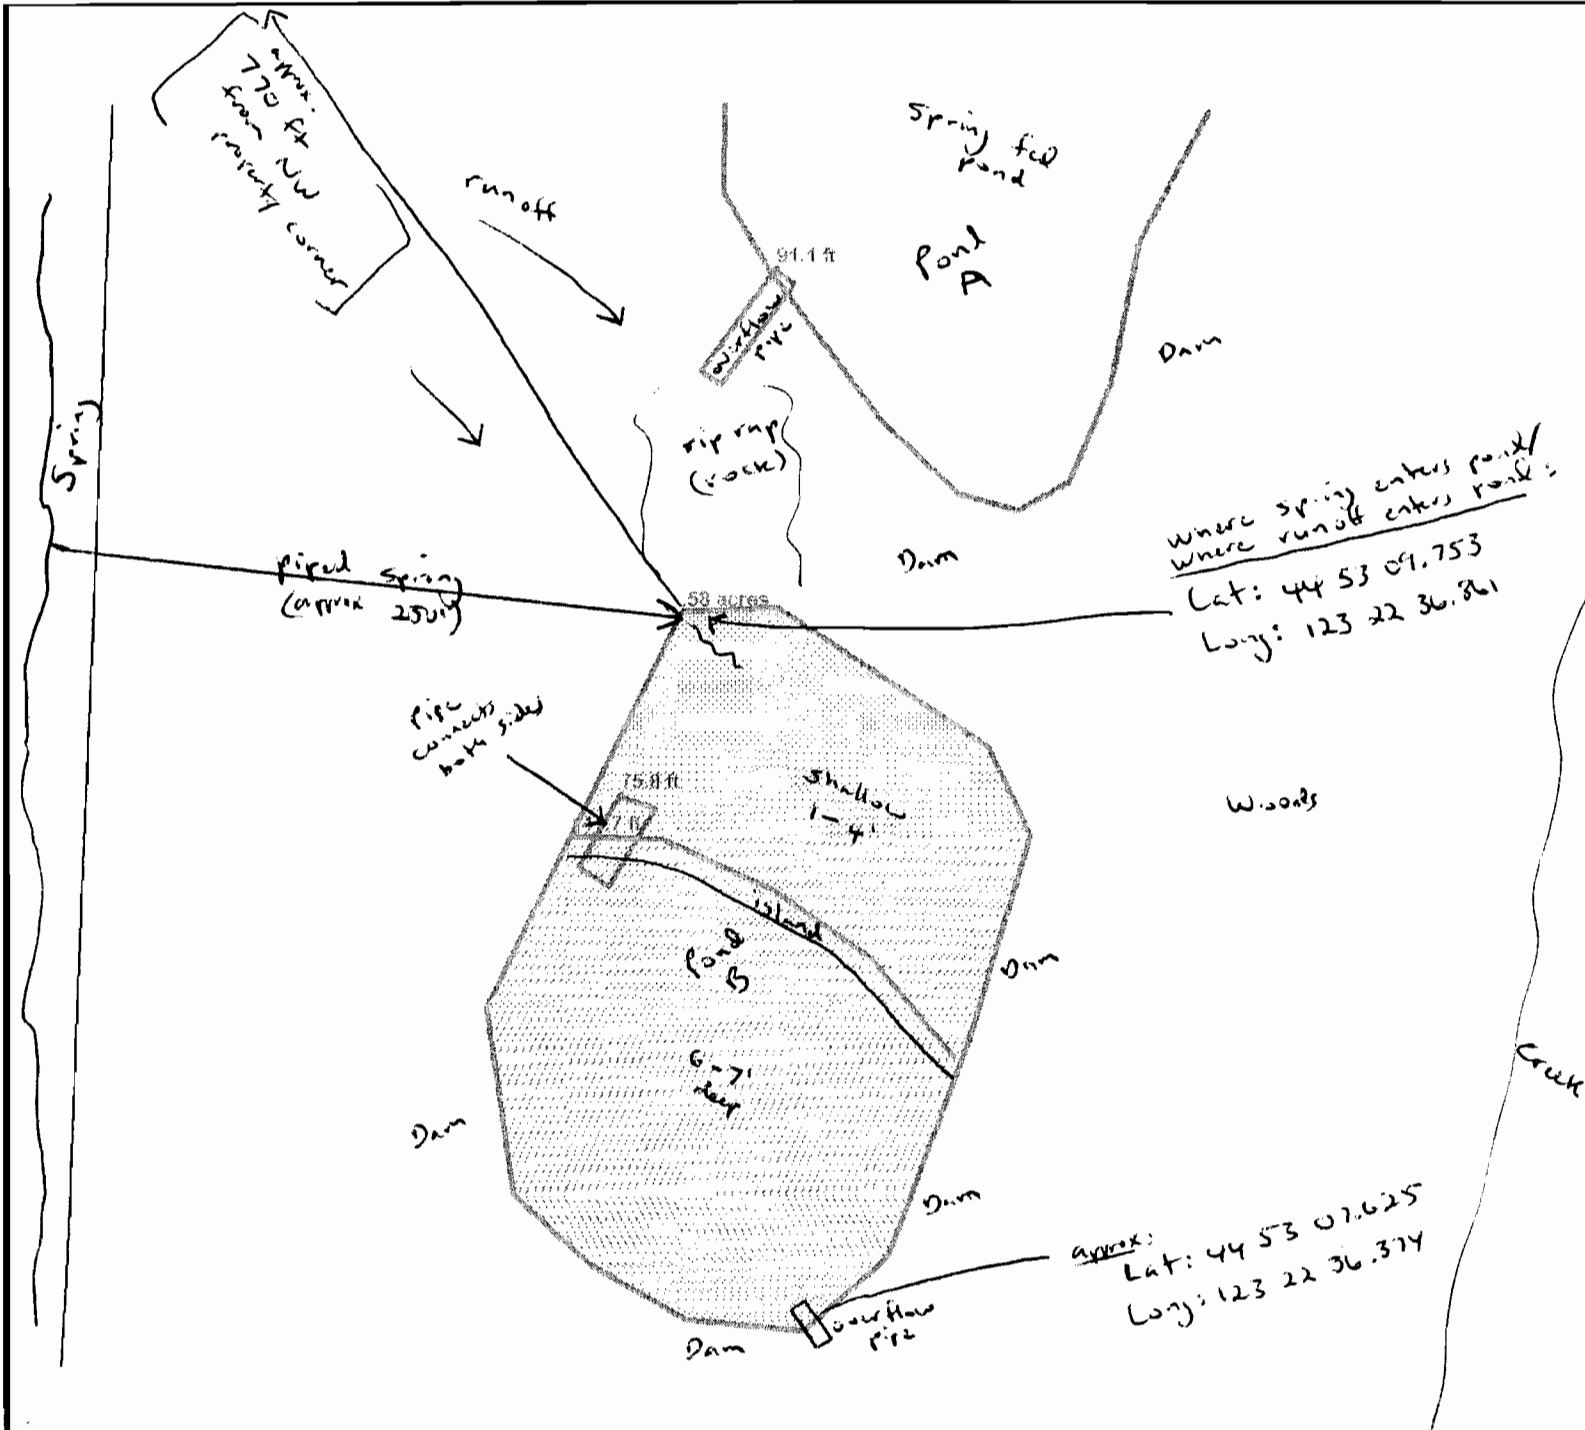

where spring enters pond/  
 where runoff enters bank:  
 Lat: 44 53 09.753  
 Long: 123 22 36.861

approx:  
 Lat: 44 53 07.625  
 Long: 123 22 36.374

1 in. = 58 ft.

This map was produced using the Polk County GIS data. The GIS data is maintained by the county to support its governmental activities. The county is not responsible for map errors, omissions, misuse or misinterpretation.