


T.31S., R. 3&4W, W. M.

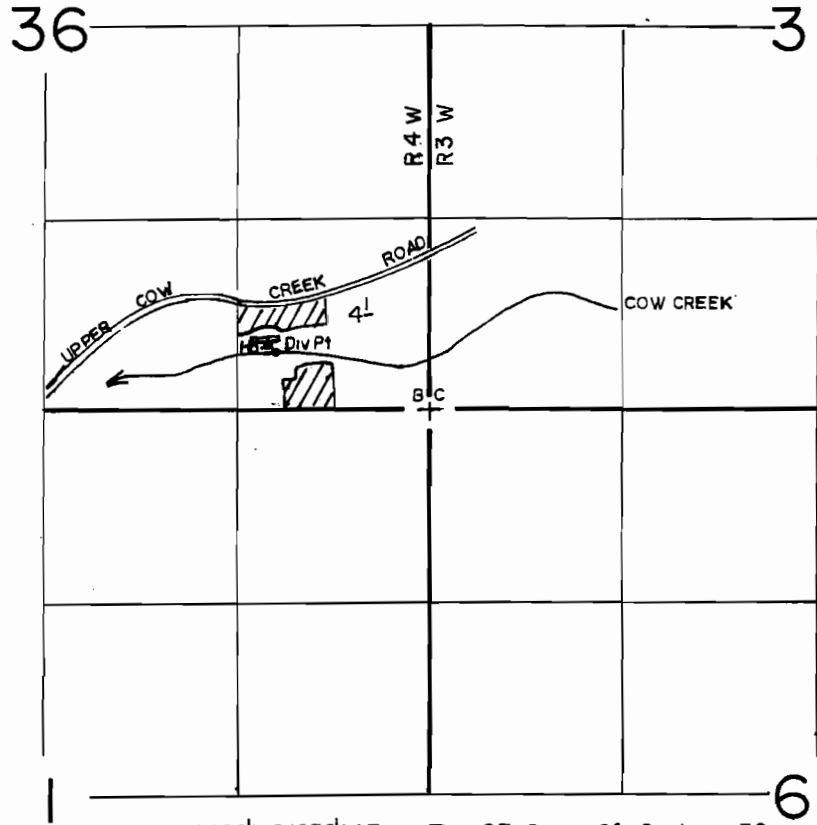

Div Pt Located 400' N & 1050' W From The SE Corner Of Section 36

SCALE: 1" = 1320'

**FINAL PROOF SURVEY
UNDER**

Application No. 54142. Permit No. 40532.....
IN NAME OF

.....ERIC.....ROBERT.....QUINN.....

Surveyed JULY 9... 1990., by B.S. JAMES.....