


DEPOE BAY

Map to accompany application for permit to appropriate the waters of an unnamed creek tributary to Depoe Bay in the N.E. $\frac{1}{4}$ of the S.W. $\frac{1}{4}$ of Sec. 4 T.9S.R.11W.W.M., Lincoln Co. Ore., by the Sunset Investment Co.

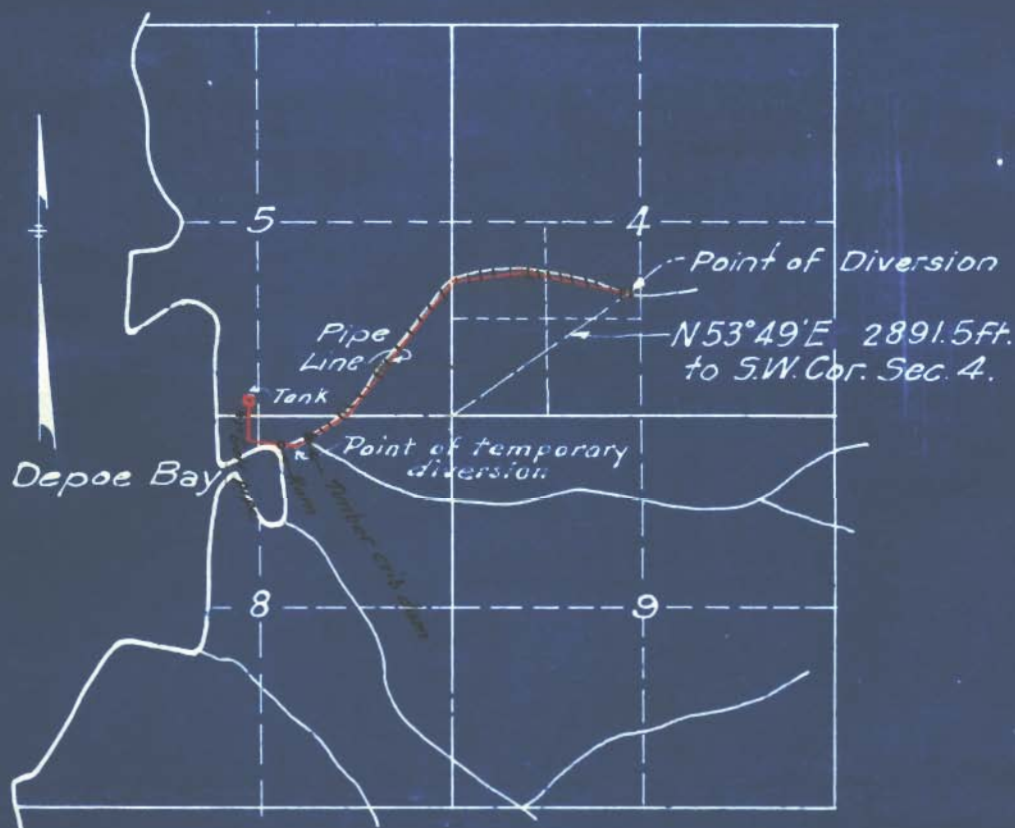

I, G. Haselton, of Portland, Ore., do hereby certify that this map was made from notes taken during an actual survey made under my supervision on Jan. 31, 1928 and that it correctly represents the works described in the accompanying application, together with the location of streams and ditches in the immediate vicinity

G. Haselton
 Registered Engineer #140
 State of Oregon

Application No. 12804
 Permit No. 18414