


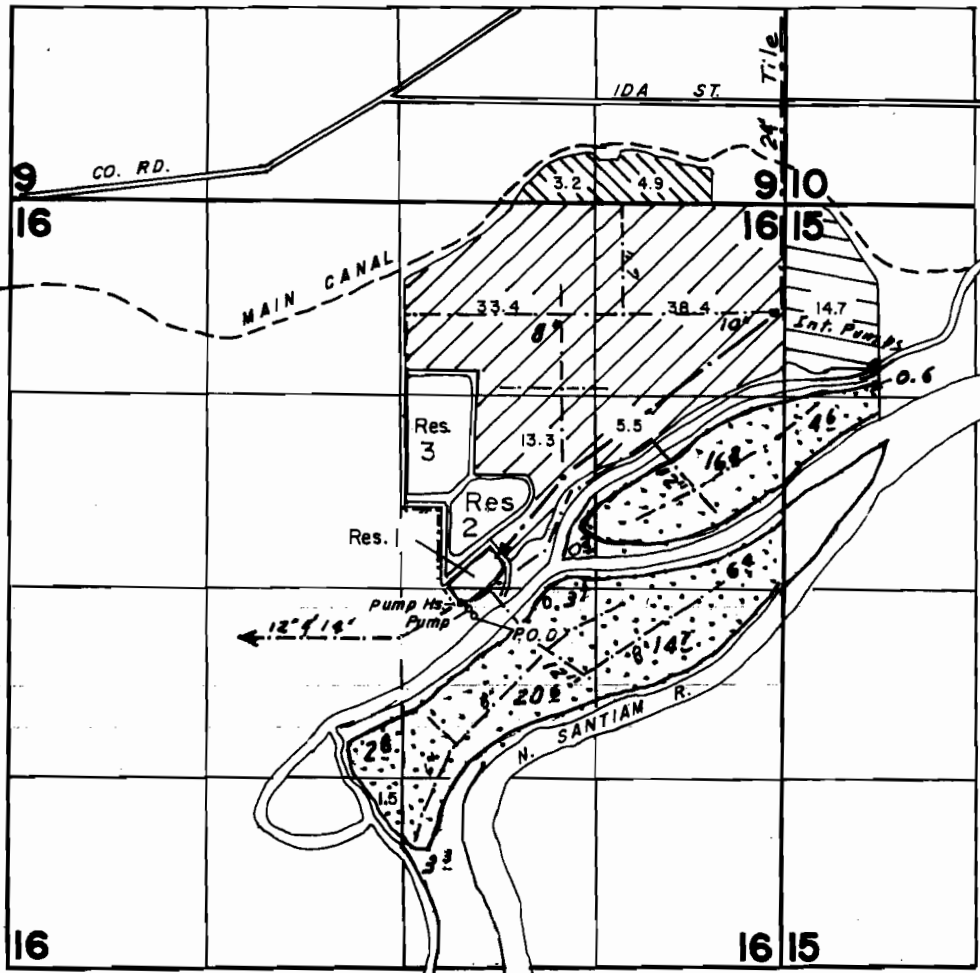

4" = 1 MI.



P. O. D. : RESERVOIR - 120' S. & 420' E. ; STREAM - 190' S. & 500' E. FROM CENTER OF SEC. 16.



PRIMARY FROM N. SANTIAM R., RES. NO. 1, 2 & 3, & SUPPLEMENTAL FROM EFFLUENT



SUPPLEMENTAL FROM RES. NO. 1, 2, 3 & EFFLUENT



SUPPLEMENTAL FROM EFFLUENT & RES. NO. 2 & 3



PRIMARY FROM N. SANTIAM R., SUPPL. FROM EFFLUENT

T. 9 S., R. 1 W., W. M.

RECEIVED

JUL 22 1998

WATER RESOURCES DEPT.  
SALEM, OREGON

**FINAL PROOF SURVEY  
UNDER**

R-74827


R-12083

Application No. 7.4826 Permit No. 5.29.38.

IN NAME OF

N. ORPAC.. F. O. O. S., I. N. C.

Surveyed JULY. 2 19.98, by ...

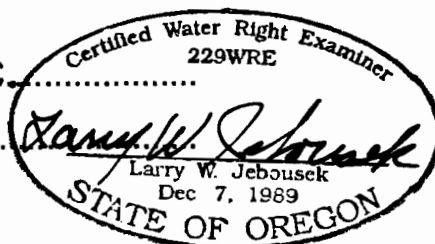

THIS MAP WAS PREPARED FOR THE PURPOSE OF IDENTIFYING THE LOCATION OF A WATER RIGHT ONLY AND IS NOT INTENDED TO PROVIDE LEGAL DIMENSIONS OR LOCATION OF PROPERTY OWNERSHIP LINES.