


T-6524

T10S, R21&22E, W.M.




T9S
T10S

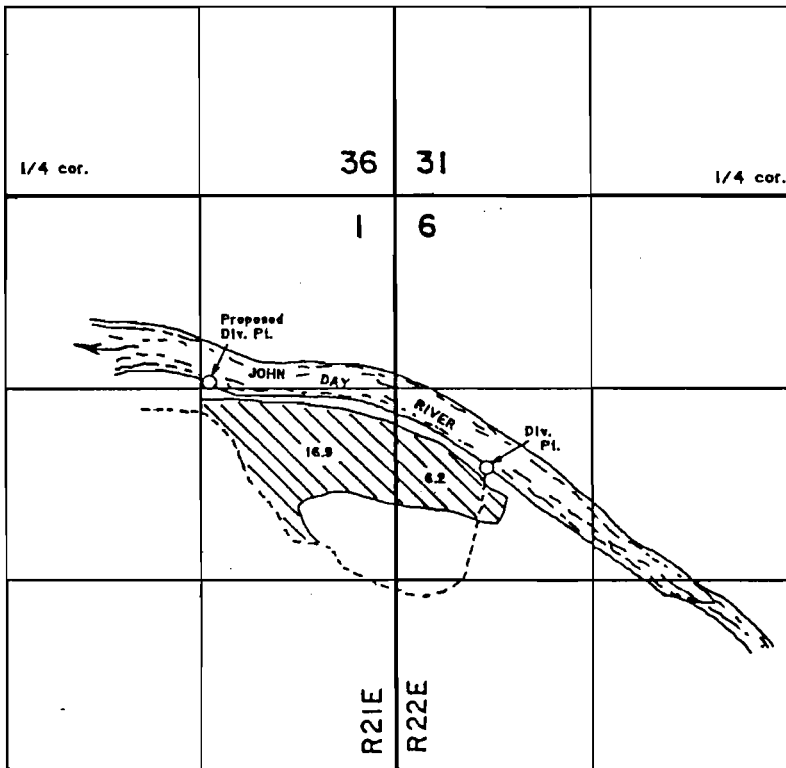

SCALE 1"=1320'

Existing Diversion Point is 1880' S. and 5900' E. of the NW cor. Sec. 1
Proposed Diversion Point is 1280' S. and 4040' E. of the NW cor. Sec. 1

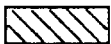

C-55644


APPLICATION MAP FOR DIVERSION POINT TRANSFER

FOR
JOHN COLLINS



BY
BAGETT-GRIFFITH & ASSOC.
P.O. BOX 476
JOHN DAY, OR. 97845

March 4, 1991

NOTE: The preparation of this map was for the purpose of identifying the location of the proposed water right and has no intent to provide dimensions or location of property ownership lines. Location information shown hereon was furnished by the applicant.

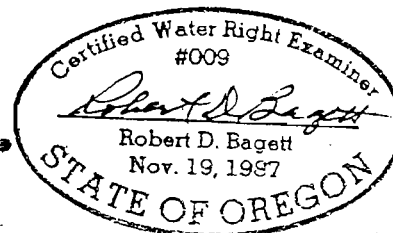

T10S, R21&22E, W.M.

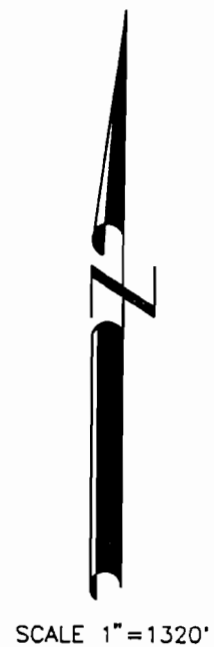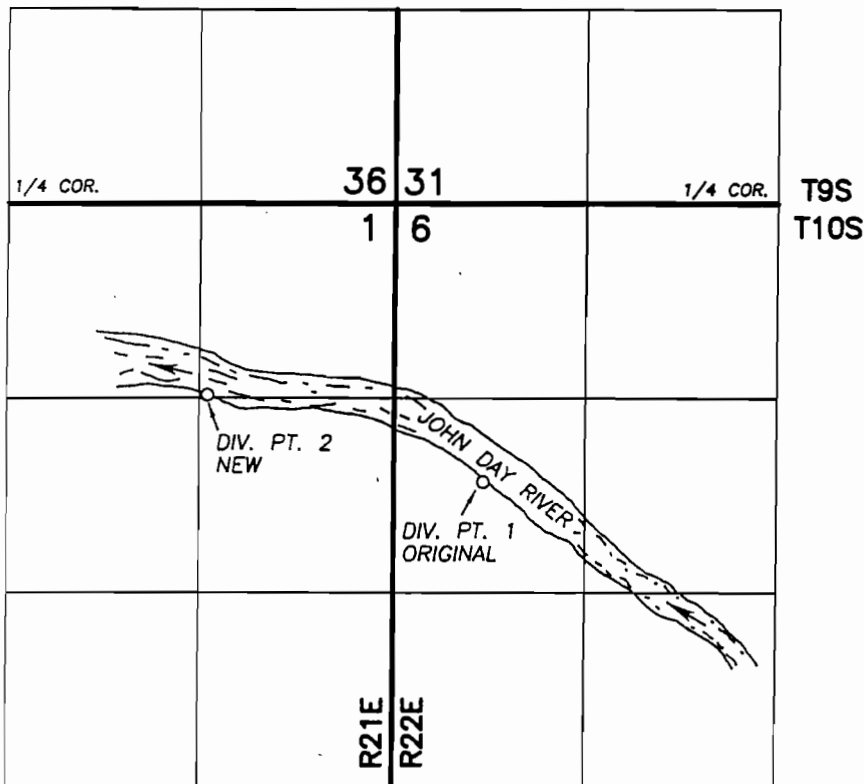

DIVERSION POINT 1 IS 1880' S. AND 5900' E. OF THE NW COR. SEC. 1
 DIVERSION POINT 2 IS 1290' S. AND 4130' E. OF THE NW COR. SEC. 1

**FINAL PROOF SURVEY
 UNDER
 TRANSFER NO. 6524
 SPECIAL ORDER VOL. 47, PAGE 406
 IN NAME OF
 JOHN AND SHERLA COLLINS**

SURVEYED JULY 12, 1996 BY ROBERT D. BAGETT

THIS MAP AMENDS MY
 MAP DATED JULY 12, 1996

NOTE: THE PREPARATION OF THIS MAP
 WAS FOR THE PURPOSE OF IDENTIFYING
 THE LOCATION OF THE PROPOSED WATER
 RIGHT AND HAS NO INTENT TO PROVIDE
 DIMENSIONS OR LOCATION OF PROPERTY
 OWNERSHIP LINES.

