

T.17 S. R. 5 W. W.M.

SECTION 2

FINAL PROOF SURVEY

UNDER

FILE NO. R-75286, PERMIT NO. R-11633

IN NAME OF

DREXIL PATRICK BEARD


LAKE COUNTY, OREGON

AUG. 29, 1998

RECEIVED

SEP 25 1998

WATER RESOURCES DEPT.
SALEM, OREGON

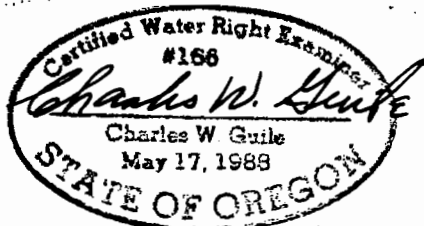


EXP. DATE 6/30/1999

CHARLES W. GUILÉ
& ASSOCIATES, CO.
Land Surveying
52 Centennial Loop
Eugene, OR 97401

ALVADORE ROAD

POINT OF DIVERSION

DIVERSION POINT IS
5.0 FT. NORTH AND
1080.0 FT. WEST OF
THE SW COR. DLC
NO. 40

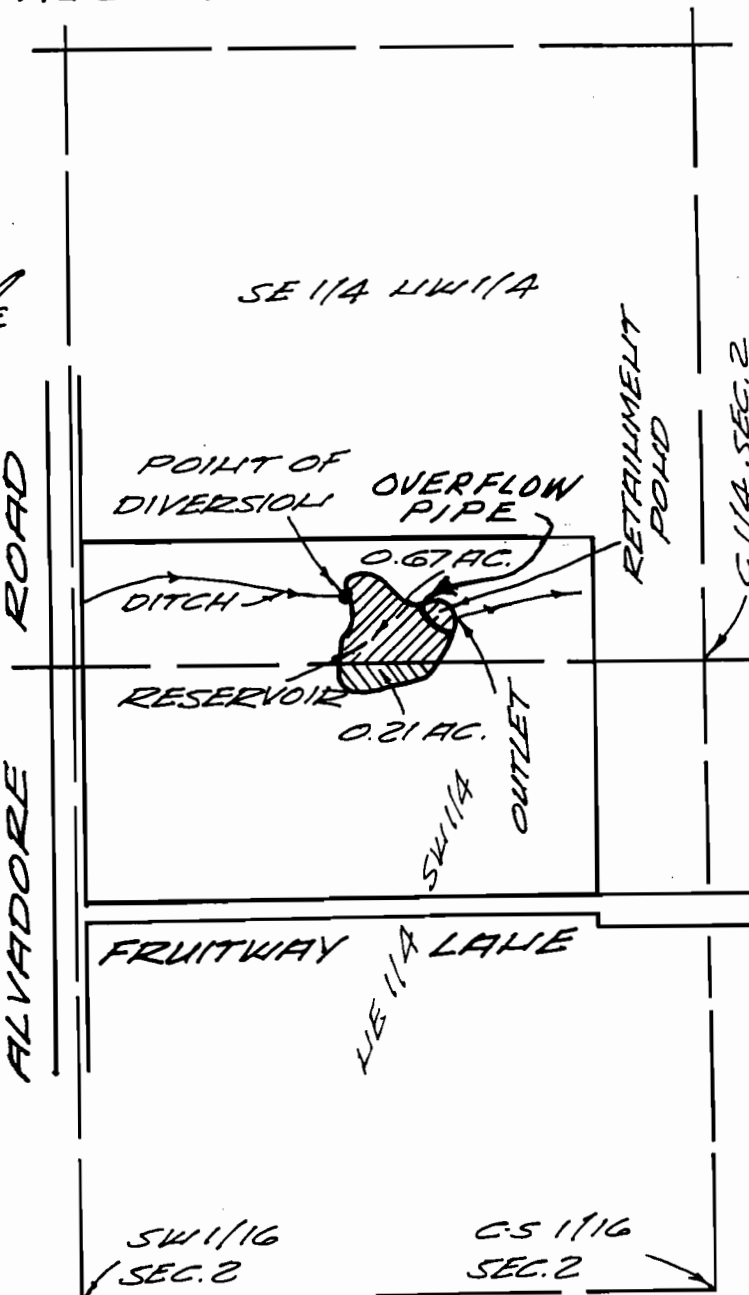

M. HAUSHAM
D.L.C.

S.W. COR.
DLC NO. 40



SCALE 1" = 400'

THIS MAP IS FOR THE PURPOSE OF LOCATING
A WATER RIGHT AND IS NOT INTENDED TO PROVIDE
DIMENSIONS FOR LOCATING PROPERTY
BOUNDARIES.

94-54