


T. 36S., R.2W., W.M.



North
Scale: 1" = 660'

 Harry & David
Irrigation under
Permit No. 20620
& T-6859

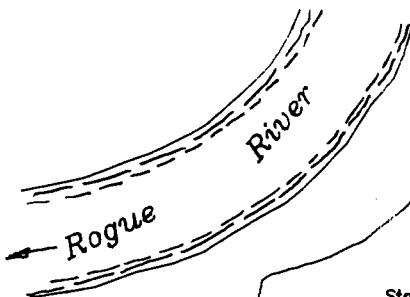

State of Oregon
State Highway Commission
Sump

OLD POINTS OF
DIVERSION FROM
KENDALL SLOUGH

SW1/4-SW1/4

SE1/4-SW1/4

Kendall Sump

NEW POINT OF DIVERSION
IS NORTH 87° & WEST 3575'
FROM SE COR. SEC. 18
50' EASEMENT (INST. #93-24848)
FOR PIPELINE & PUMPS

DLC #48

LEAD PLUG
IN CONC.

Gov't Lot 1

Gov't Lot 2

17 18
20 21

18 15
21 22

1.5 Ac.

2.0 Ac.

NW1/4-NW1/4

NE1/4-NW1/4

28.4 Ac.

34.2 Ac.

SW1/4-NW1/4

SE1/4-NW1/4

10.8 Ac.

8.4 Ac.

0.2 Ac.

STATE
HIGHWAY
EASEMENT

KIRTLAND

ROAD


DLC #48

DLC #48

RECEIVED

MAR 1 1996

WATER RESOURCES DEPT.
SALEM, OREGON

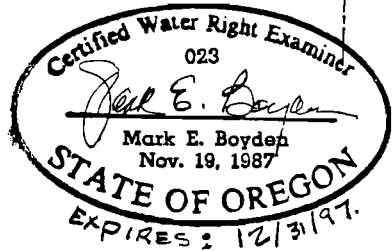

Final Proof Map

Harry & David an Oregon Corporation