


TOWNSHIP 27 SOUTH, RANGE 16 EAST, W.M.


SEP 26 1996

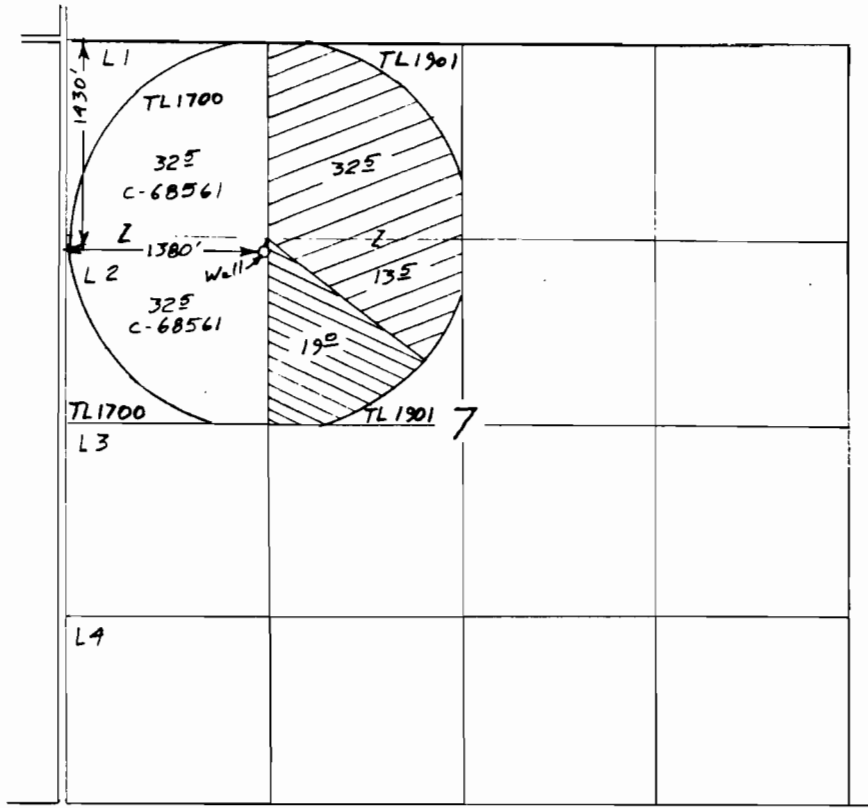

- ⊙ C-68444
- ⊙ C-48731

Surveyed June 10, 1994

Claim of Beneficial Use Map
for
HERBERT VLOEDMAN, JR
§
NORTHWEST FARM CREDIT SERVICES
Under TRANSFER T-7300

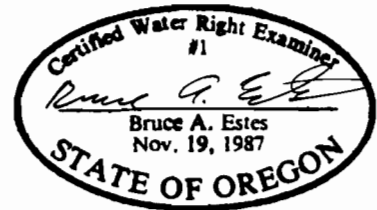

This map is for the purpose of locating a water right only and has no intent to provide legal dimensions or the location of property lines.

ESTES SURVEYS

6293 Sunnyview Rd. NE 60382 Arnold Rd.
Salem, OR 97305 Bend, OR 97702
(503) 585-7593 (503) 382-7391