


TOWNSHIP 27 SOUTH, RANGE 16 EAST, W.M.


SEP 26 1996

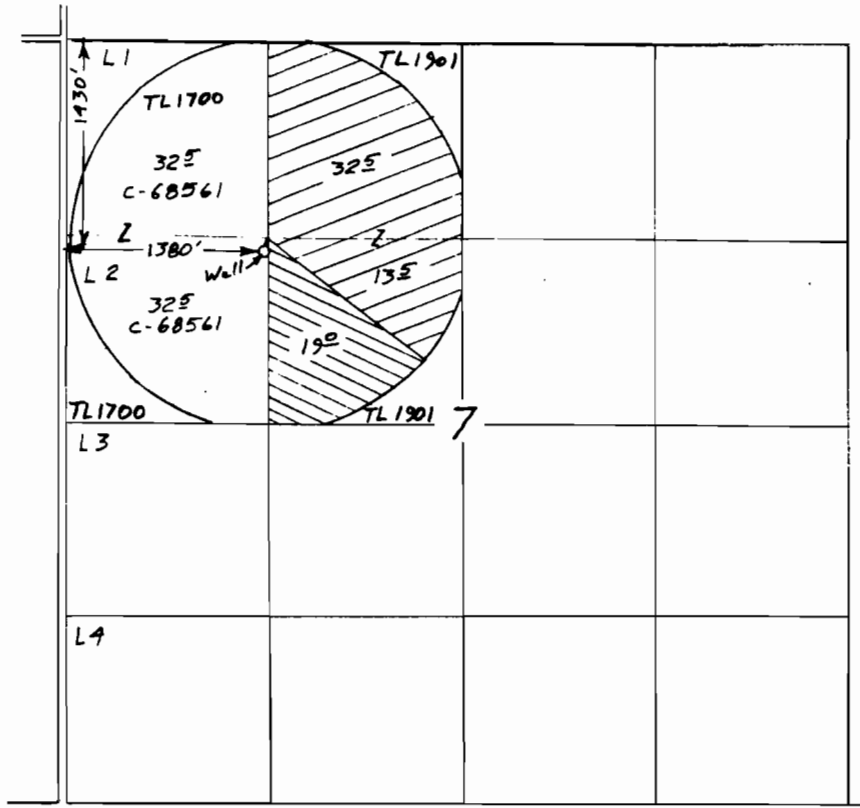

- ⊙ C-68444
- ⊙ C-48731

Surveyed June 10, 1994

Claim of Beneficial Use Map
for
HERBERT VLOEDMAN, JR
§
NORTHWEST FARM CREDIT SERVICES
Under TRANSFER T-7300

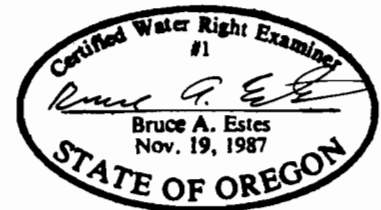

This map is for the purpose of locating a water right only and has no intent to provide legal dimensions or the location of property lines.

ESTES SURVEYS

6293 Sunnyview Rd. NE Salem, OR 97305 (503) 585-7593
60382 Arnold Rd. Bend, OR 97702 (503) 382-7391