


T. 2 N., R. 48 E., W.M.

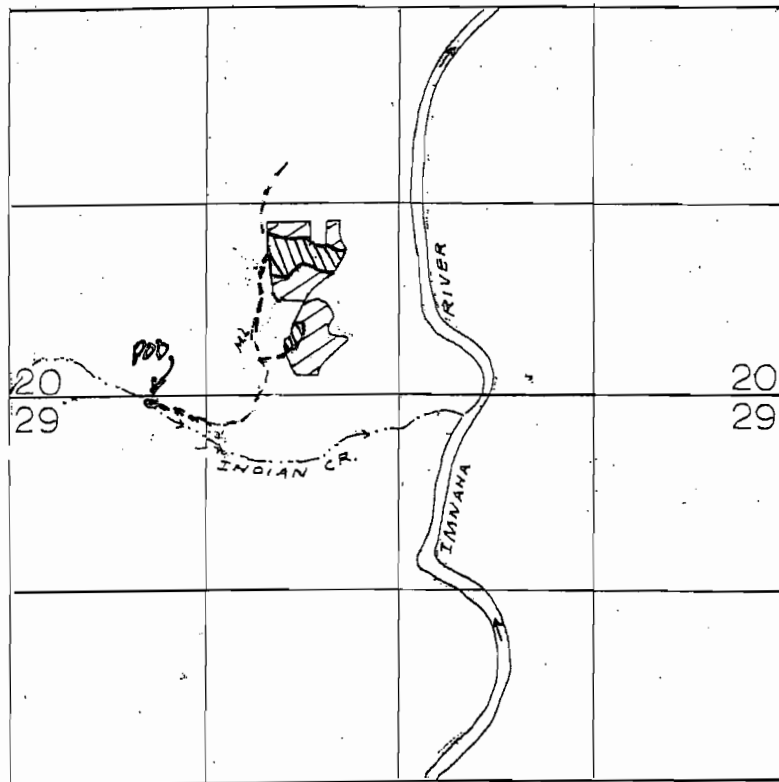

1" = 1320'

 2.9 acres April 5, 1893 Priority date
 5.1 acres Permit 38478

POD is 50 feet South and 975 feet East of the NW Corner of Section 29

FINAL PROOF SURVEY

UNDER

Application No. 50977 Permit No. 38478
IN NAME OF

BEN FIELDS

Surveyed 10-6, 1990, by K. KEMP

RECEIVED

DEC 30 1994

WATER RESOURCES DEPT
SALEM, OREGON

GC 6-2-2010