


T10 & 11S, R6W, W.M.

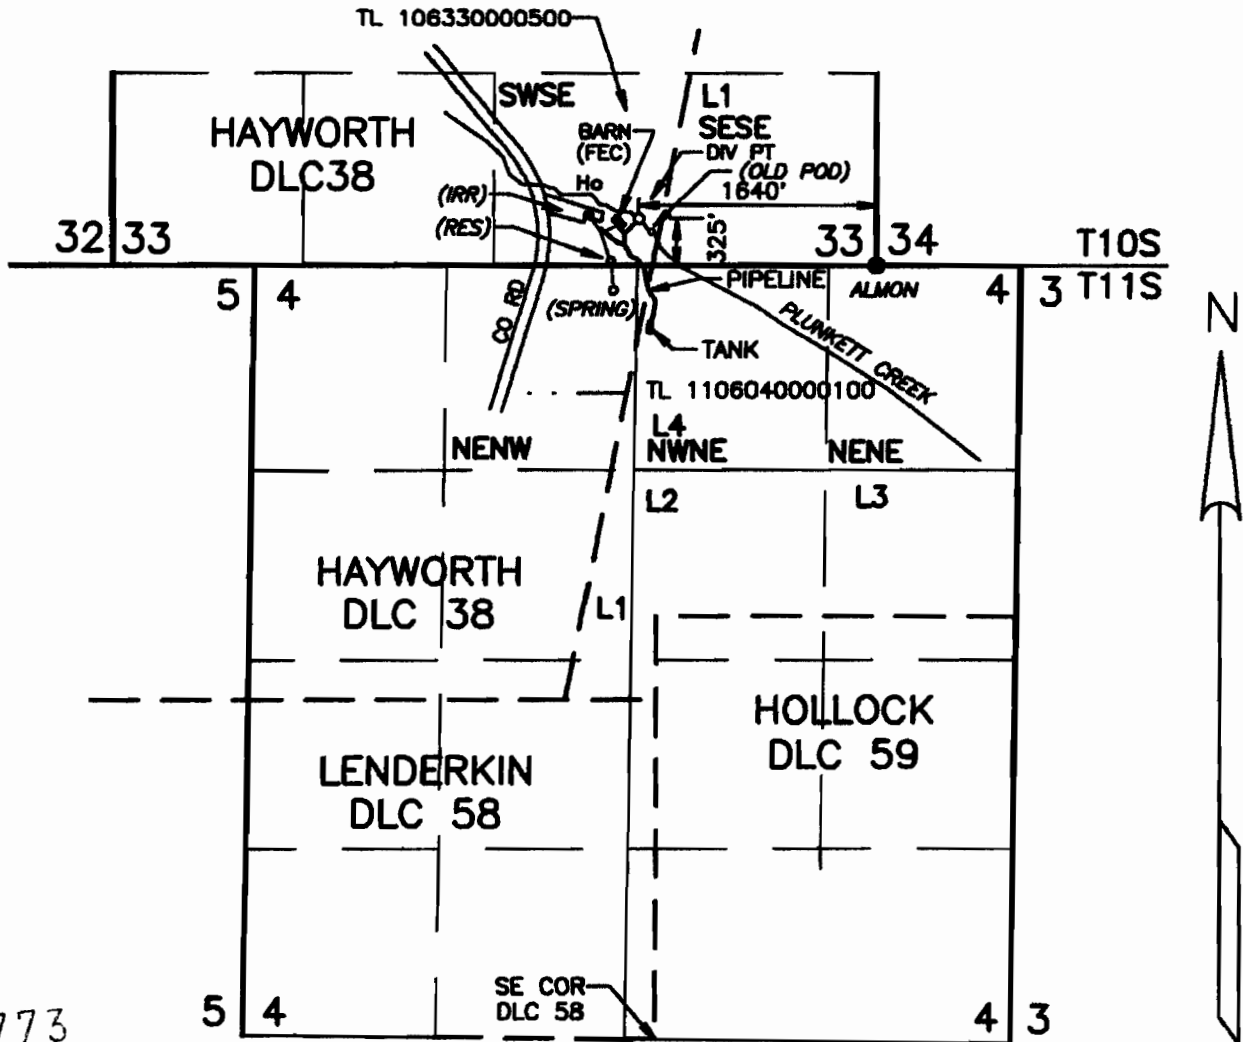

TRANSFER APPLICATION SURVEY MAP

IN THE NAME OF

A. Fred Beazell

Permit No. 38792

Cert. No. 45861

DIV PT: 325 FT NORTH AND 1640 FT WEST OF THE
SOUTHEAST CORNER SEC 33, T10S R6W, W.M.

ALMON - BENTON COUNTY ALUMINUM MONUMENT

BEARINGS BY SOLAR OBSERVATION, CORNER & MAPPING
INFORMATION FROM BENTON COUNTY SURVEYOR'S OFFICE.
THE FOREST EDUCATION CENTER (FEC) IS LOCATED IN
THE RECONSTRUCTED BARN.


Prepared December 2, 2008
PARSONS SURVEYING
1915 S.E. Stone St.
Corvallis, OR 97333
541-752-7515
Project No.

This map is for location of Water Right Application
only and does not constitute a boundary survey.

RECEIVED

JAN 20 2009

WATER RESOURCES DEPT
SALEM, OREGON

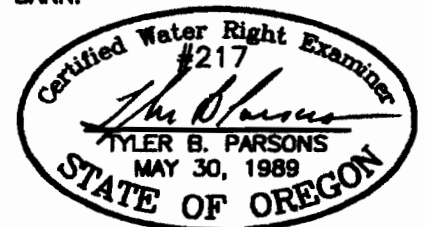

EXP: 12/31/2010