

KELSO ROAD

3 2

10 11

N.E. $\frac{1}{4}$ OF N.E. $\frac{1}{4}$

$\frac{5}{8}$ " IRON ROD
N. $\frac{1}{16}$ CORNER
SECTIONS 10 & 11

WELL NO. 2
(DOMESTIC)

3" BURIED
MAINLINE

24.40 ACRES
CONTAINER AND
NURSERY STOCK


WELL NO. 1

S.E. $\frac{1}{4}$ OF N.E. $\frac{1}{4}$

This drawing is an exhibit for a Final Proof Survey. It is not a Land Survey. Property lines and/or other lines of occupation shown hereon are not represented by the undersigned to meet accuracy standards of Land Surveys.




SCALE: 1" = 400'

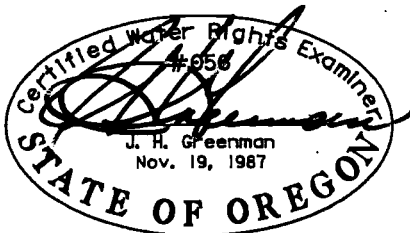

SECTION 10, T.2S., R. 4E., W.M.
CLACKMAS COUNTY, OREGON

Application No. G-12340

Permit No. G-11249

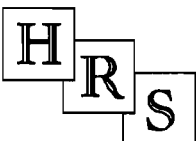

**HANER, ROSS &
SPORSEEN, INC.**

15 S.E. 82ND DRIVE
GLADSTONE, OREGON 97027

**BOYKO NURSERY, INC.
FINAL PROOF SURVEY**

622AA