


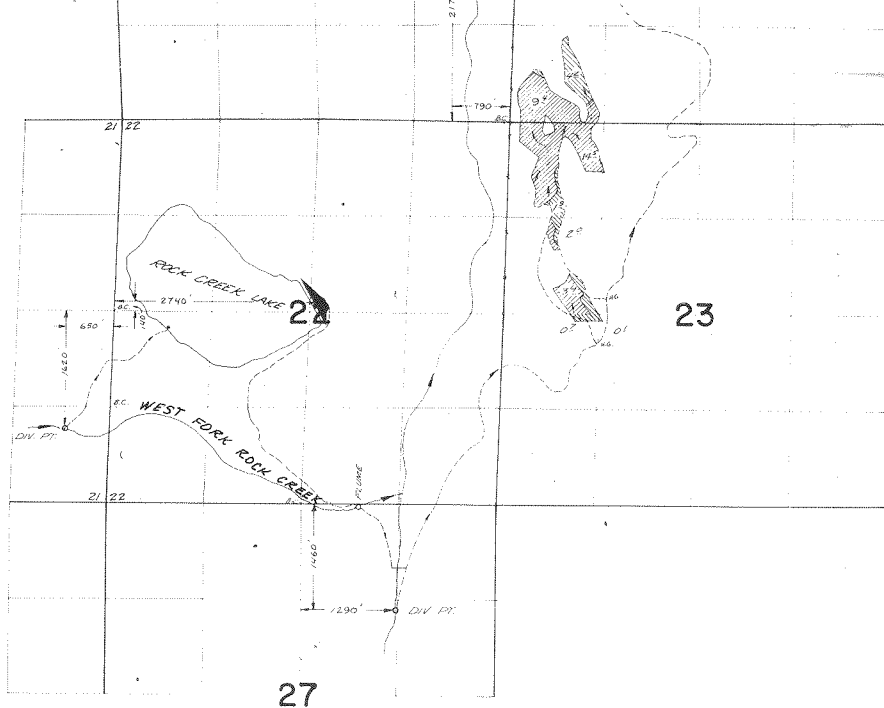

10

15

14

QIV. PT*

DIV. PT.

ROCK

0950

2300'


22

—

20

21	22
----	----

T.12 & 13S. R.24 & 25E. W.M.

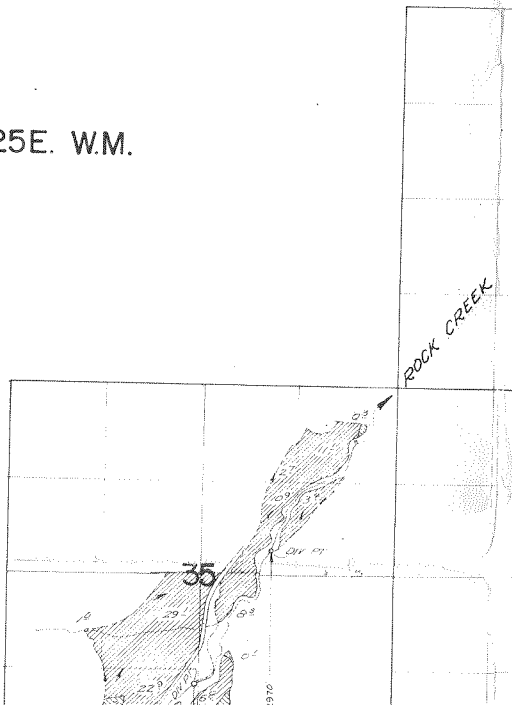

1
25

30

WEEK

36

31

LOT 4

LOT 3



LOT 2

LOT 1

LOT 2

R. 24 E.
R. 25 E.

6

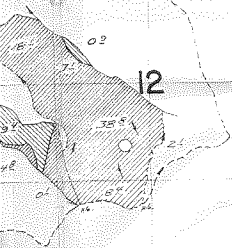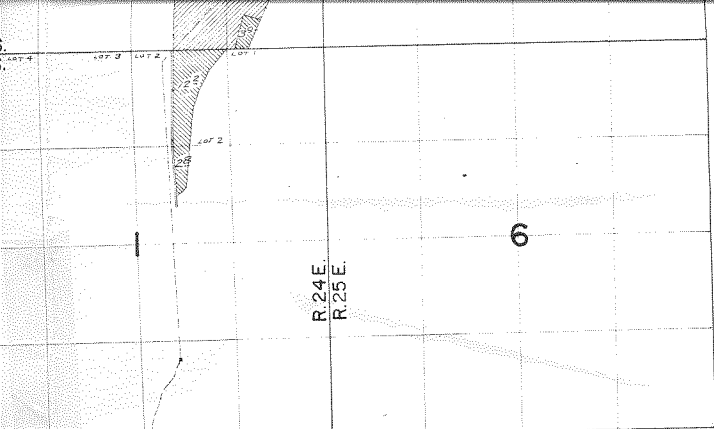


PERMIT #22983 SUPPLEMENTAL



PERMIT #22983 PRIMARY

13

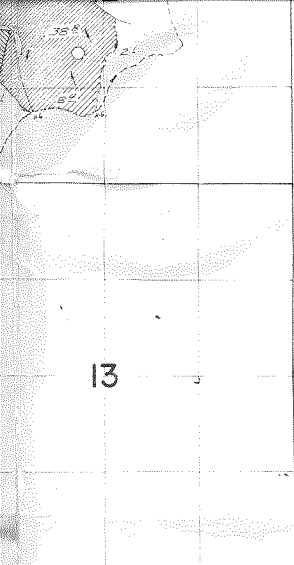

PERMIT #22983 SUPPLEMENTAL



PERMIT #22983 PRIMARY

13

R-1635
P-22983
P-22984

FINAL PROOF SURVEY

UNDER

APPLICATION NOS. 29144 PERMIT NOS. 22983

R-29146

R-1635

29147

22984

IN NAME OF

CLINTON O. and FLORA H. HARRIS

SURVEYED JUNE 7, 1968 BY V. GARNER