


RECEIVED

# T. 2N., R. 31E., W.M.

UMATILLA COUNTY

SEP 08 2000

WATER RESOURCES DEPT.  
SALEM, OREGON

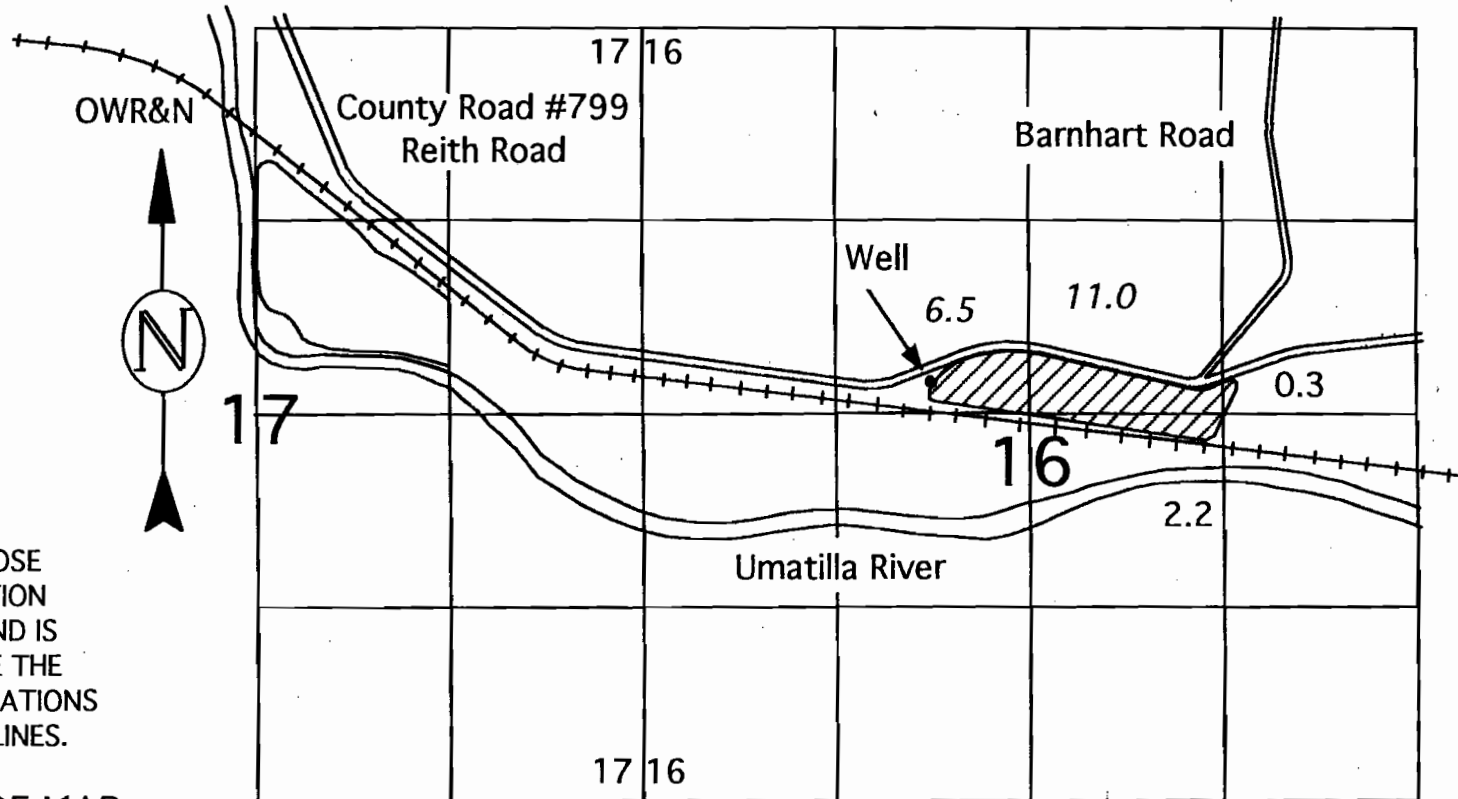

THIS MAP IS FOR THE PURPOSE OF IDENTIFYING THE LOCATION OF WATER RIGHTS ONLY AND IS NOT INTENDED TO PROVIDE THE LEGAL DIMENSIONS OR LOCATIONS OF PROPERTY OWNERSHIP LINES.

## WATER RIGHTS PROOF MAP

IN NAME OF


Dean Forth

Well Loc. 200' North & 1950' East of West 1/4 of Section 16

SCALE 1" = 1320'



Permit# G-12963

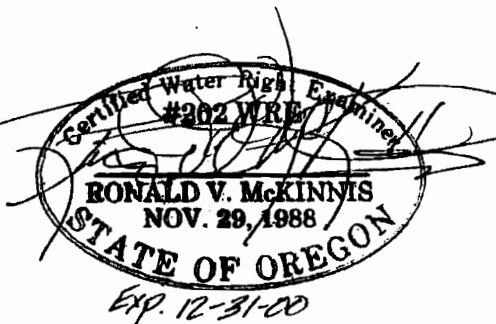

ENGINEERING - LAND SURVEYING - WATER RIGHTS  
**R. V. McKINNIS ENGINEERING**  
 79980 Prindle Loop Road  
 Hermiston, Oregon 97838  
 (541) -567-2017

