

RECEIVED

# FINAL PROOF SURVEY

Located in portions of SW 1/4 of the NW 1/4  
Section 34, Township 29 South, Range 11 West, W.M.  
Coos County, Oregon  
TL 1700

MAY 28 1997


WATER RESOURCES DEPT.  
SALEM, OREGON



1" = 400 FEET

### LEGEND

- P.O.D.
- P.O.B.
- IRRIGATED AREA
- PIPE

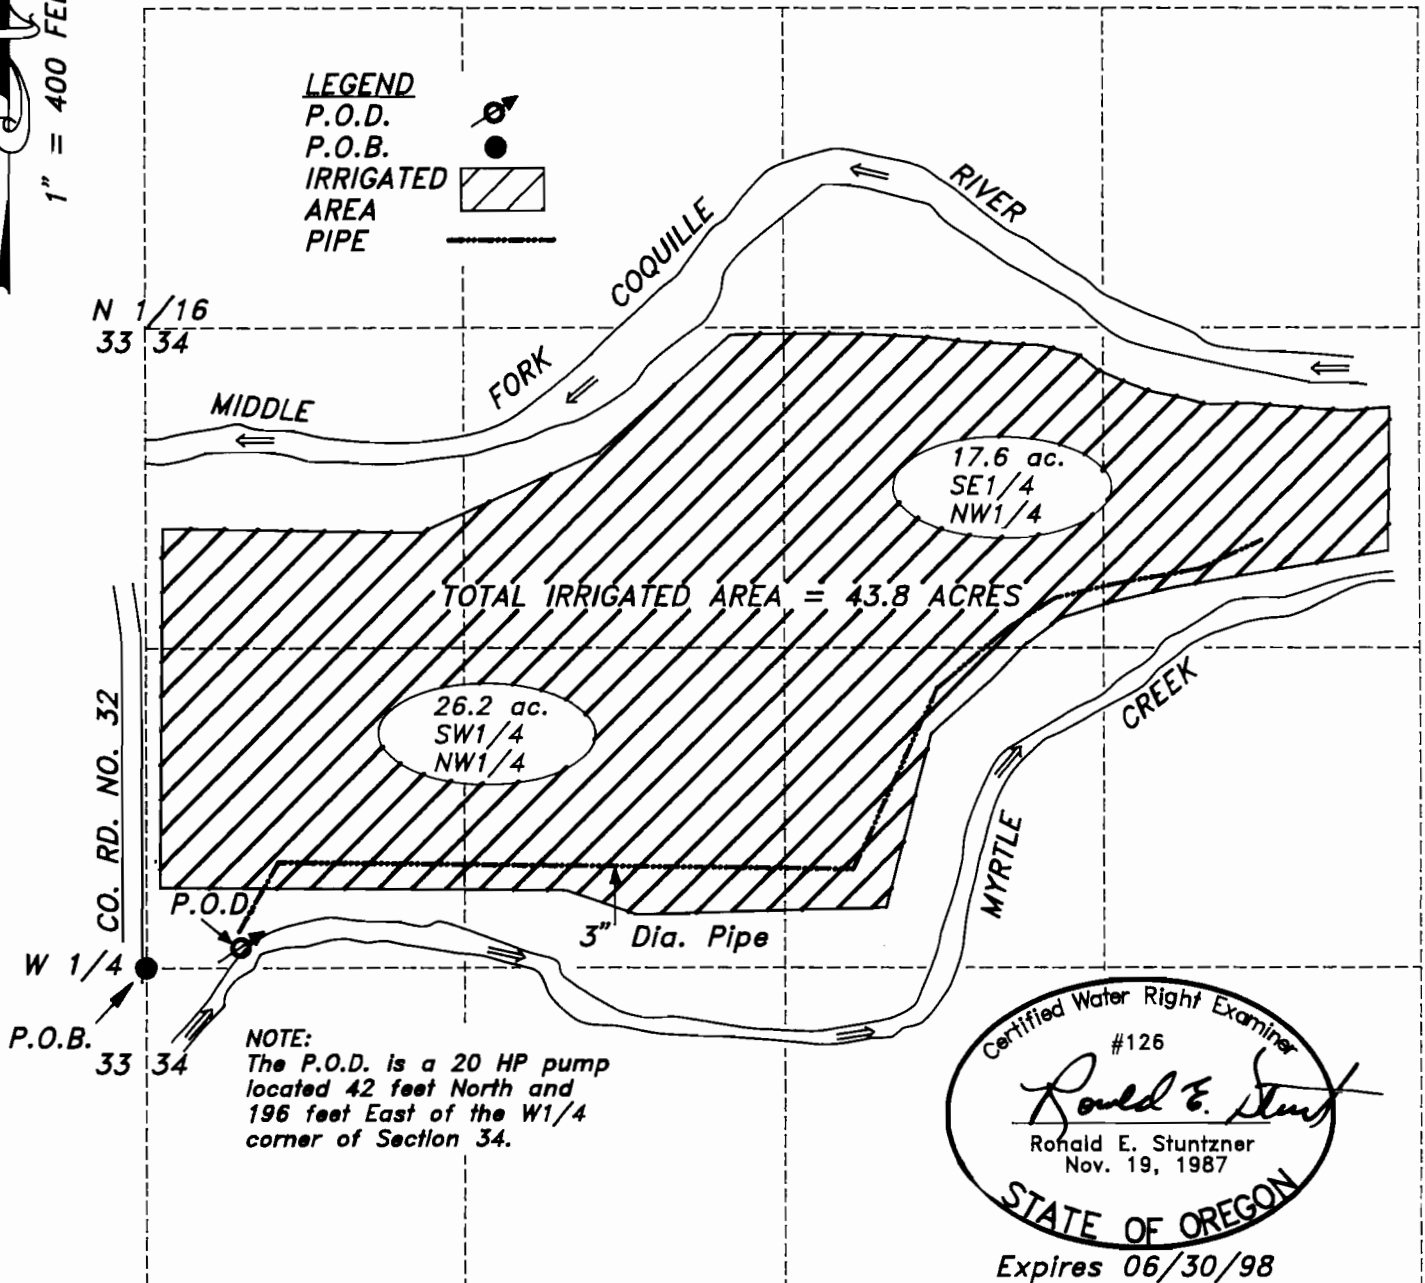

NOTE:  
The P.O.D. is a 20 HP pump  
located 42 feet North and  
196 feet East of the W1/4  
corner of Section 34.

Certified Water Right Examiner  
#126  
*Ronald E. Stuntzner*  
Ronald E. Stuntzner  
Nov. 19, 1987  
STATE OF OREGON  
Expires 06/30/98

Prepared For: Steve Martinez  
Prepared By: Dennis Goude  
Date Prepared: May 19, 1997

Certificate No. 22211  
Permit No. 20884  
Transfer No. 7047

**Stuntzner Engineering  
& Forestry, LLC**

ENGINEERING \* LAND SURVEYING \* FORESTRY  
PLANNING \* WATER RIGHTS

705 South 4th St.  
Post Office Box 118  
Coos Bay, Oregon 97420  
Phone (541) 267-2872  
Fax (541) 267-0588

**EXAMINERS DISCLAIMER STATEMENT**

The preparation of this map was for the purpose of identifying the location of the Water Right only and has no intent to provide dimensions or location of property ownership lines.