


75223
T4703

T. 14 ~~15~~ S. R. 16 E. W.M.

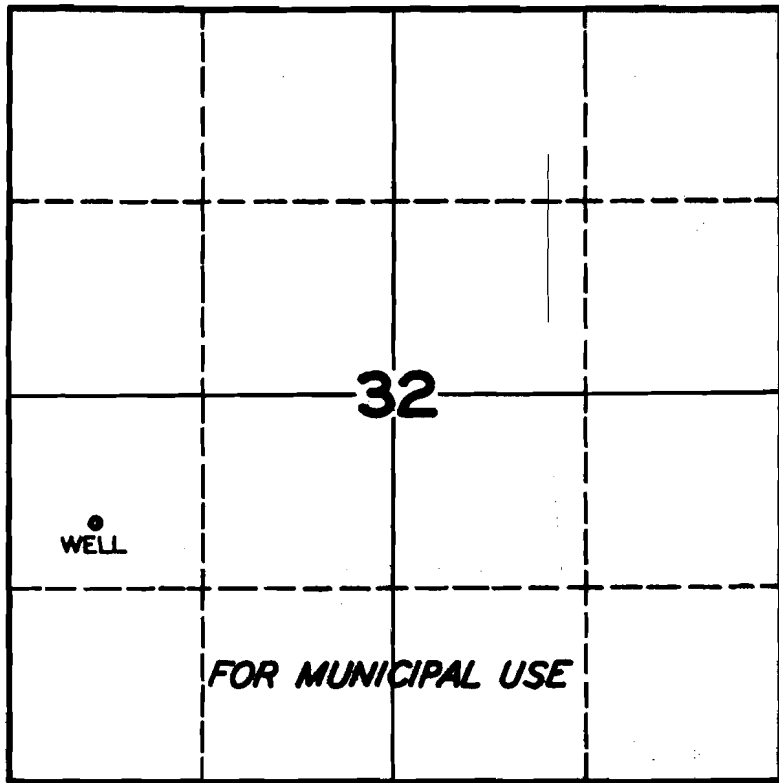

**FINAL PROOF SURVEY
UNDER**

Application No. U-147 Permit No. U-140

IN NAME OF
PACIFIC POWER & LIGHT CO.

Surveyed APR. 30 1946 by *[Signature]*