


T. 8&9S., R.4W., W.M.

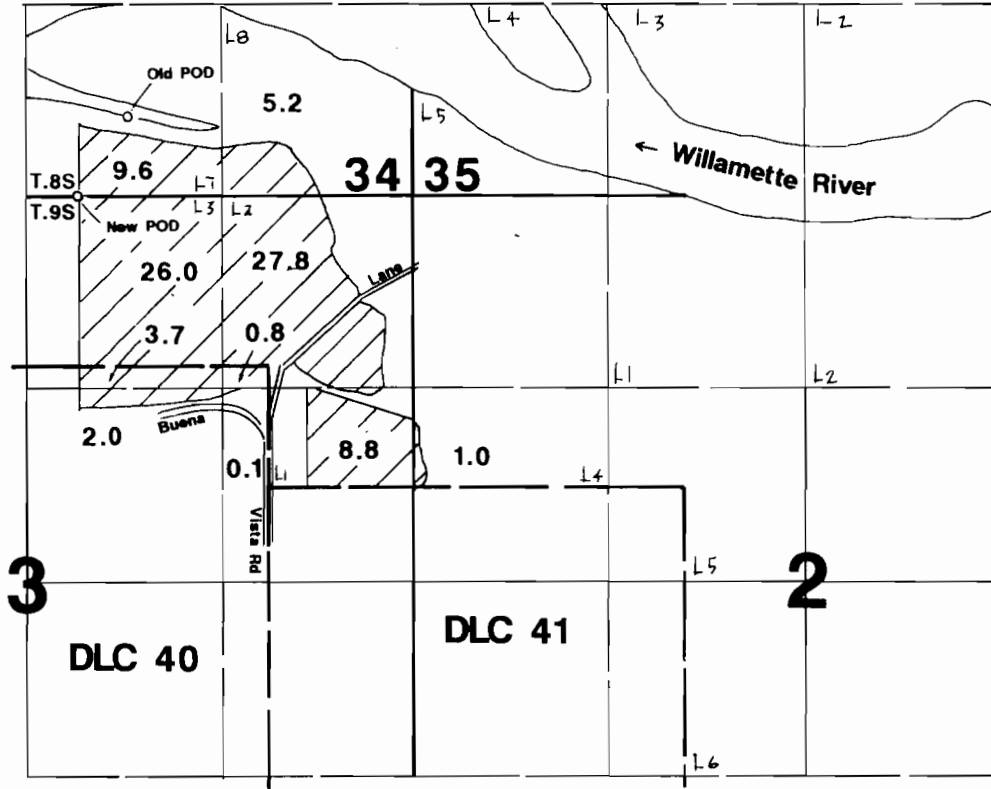


Area Irrigated

New POD located 2320'W from SE corner Section 34.

RECEIVED
AUG 28 1997
WATER RESOURCES DEPT
SALEM, OREGON

Final Proof Survey

Transfer #: T-6857

In Name Of

Wigrich Farm Inc.

Surveyed on August 14, 1997 by JM Schuette

THIS MAP WAS PREPARED FOR THE PURPOSE OF IDENTIFYING THE LOCATION OF A WATER RIGHT ONLY AND IS NOT INTENDED TO PROVIDE LEGAL DIMENSIONS OR LOCATION OF PROPERTY OWNERSHIP LINES.

