


Township 6 South, Range 1 East, W.M.
 Section 18 and Portions of Sections 7, 8, 17, 19 & 20

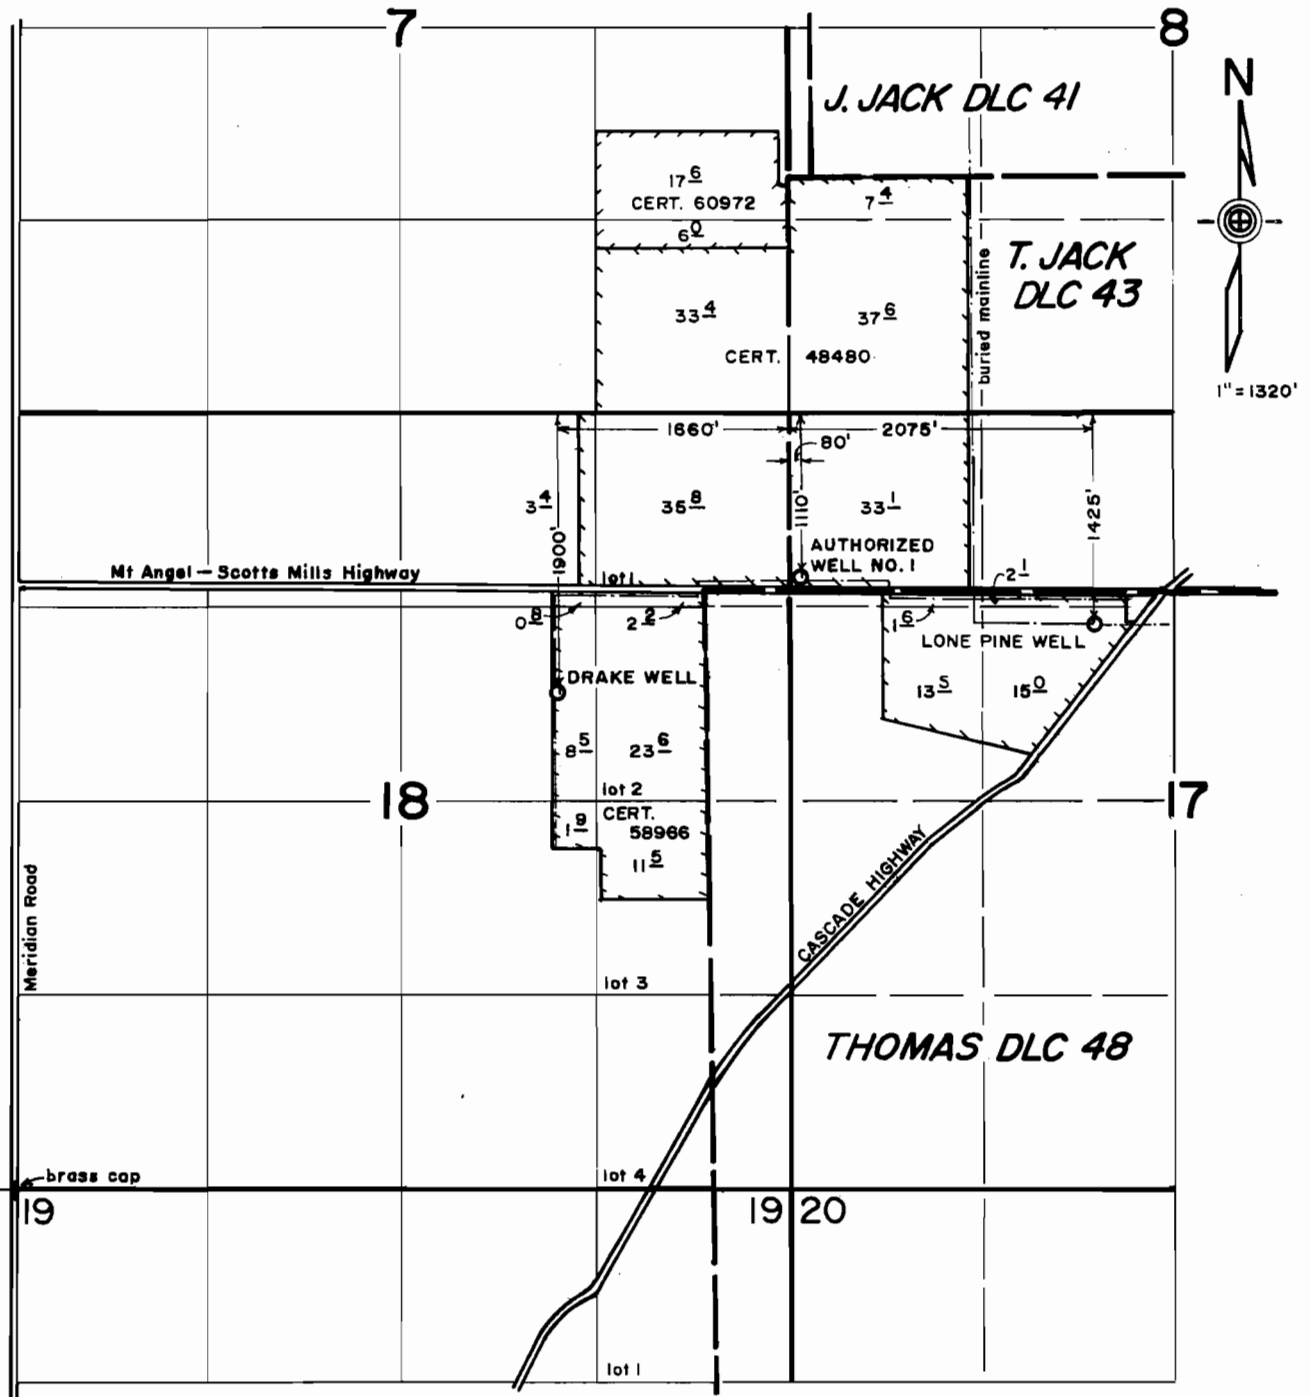


FINAL PROOF SURVEY
 under
 Transfer 6399
 in name of
KRAEMER FARMS
 Jan. 23, 1997

RECEIVED

FEB 12 1997

WATER RESOURCES DEPT
 SALEM, OREGON

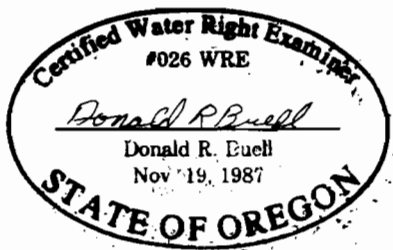

THIS MAP WAS PREPARED FOR THE PURPOSE OF IDENTIFYING THE LOCATION OF A WATER RIGHT ONLY AND IS NOT INTENDED TO PROVIDE LEGAL DIMENSIONS OR LOCATION OF PROPERTY OWNERSHIP LINES.