


RECEIVED

AUG 25 1997

T.38S.,R.4W., W.M.

WATER RESOURCES DEPT.
SALEM, OREGON

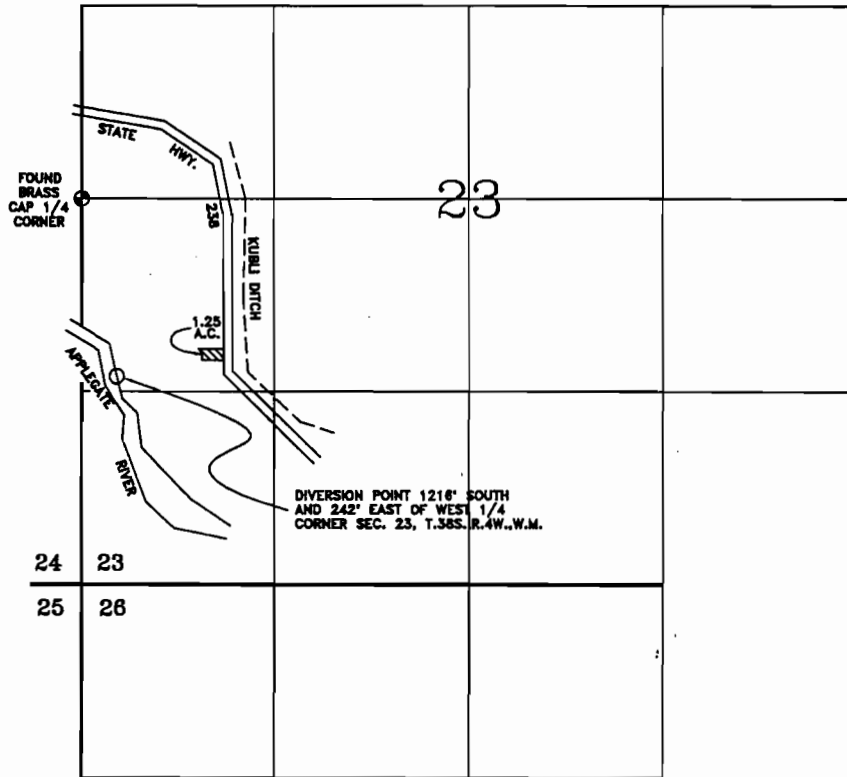

FINAL PROOF SURVEY
 SEE RIGHT PERFECTED UNDER
 PERMIT NO.46689 APPLICATION T-7249

AUGUST 5, 1997

AL LEMBKE
 13719 HIGHWAY 238
 JACKSONVILLE, OREGON 97530
 (541)846-9315

PREPARED BY:



TIMBERLINE
 KKB
 LAND SURVEYING

KERRY K. BRADSHAW L.S. 2271
 P.O. BOX 3064
 CENTRAL POINT OREGON 97502
 (541)664-7510 CELL 944-6692

