


Claim of Beneficial Use Map
Place of Use
Port of Portland
 Multnomah County, Oregon
 Permit G-13387, Application G-14488
 Township 1 North, Range 2 East (W.M.)

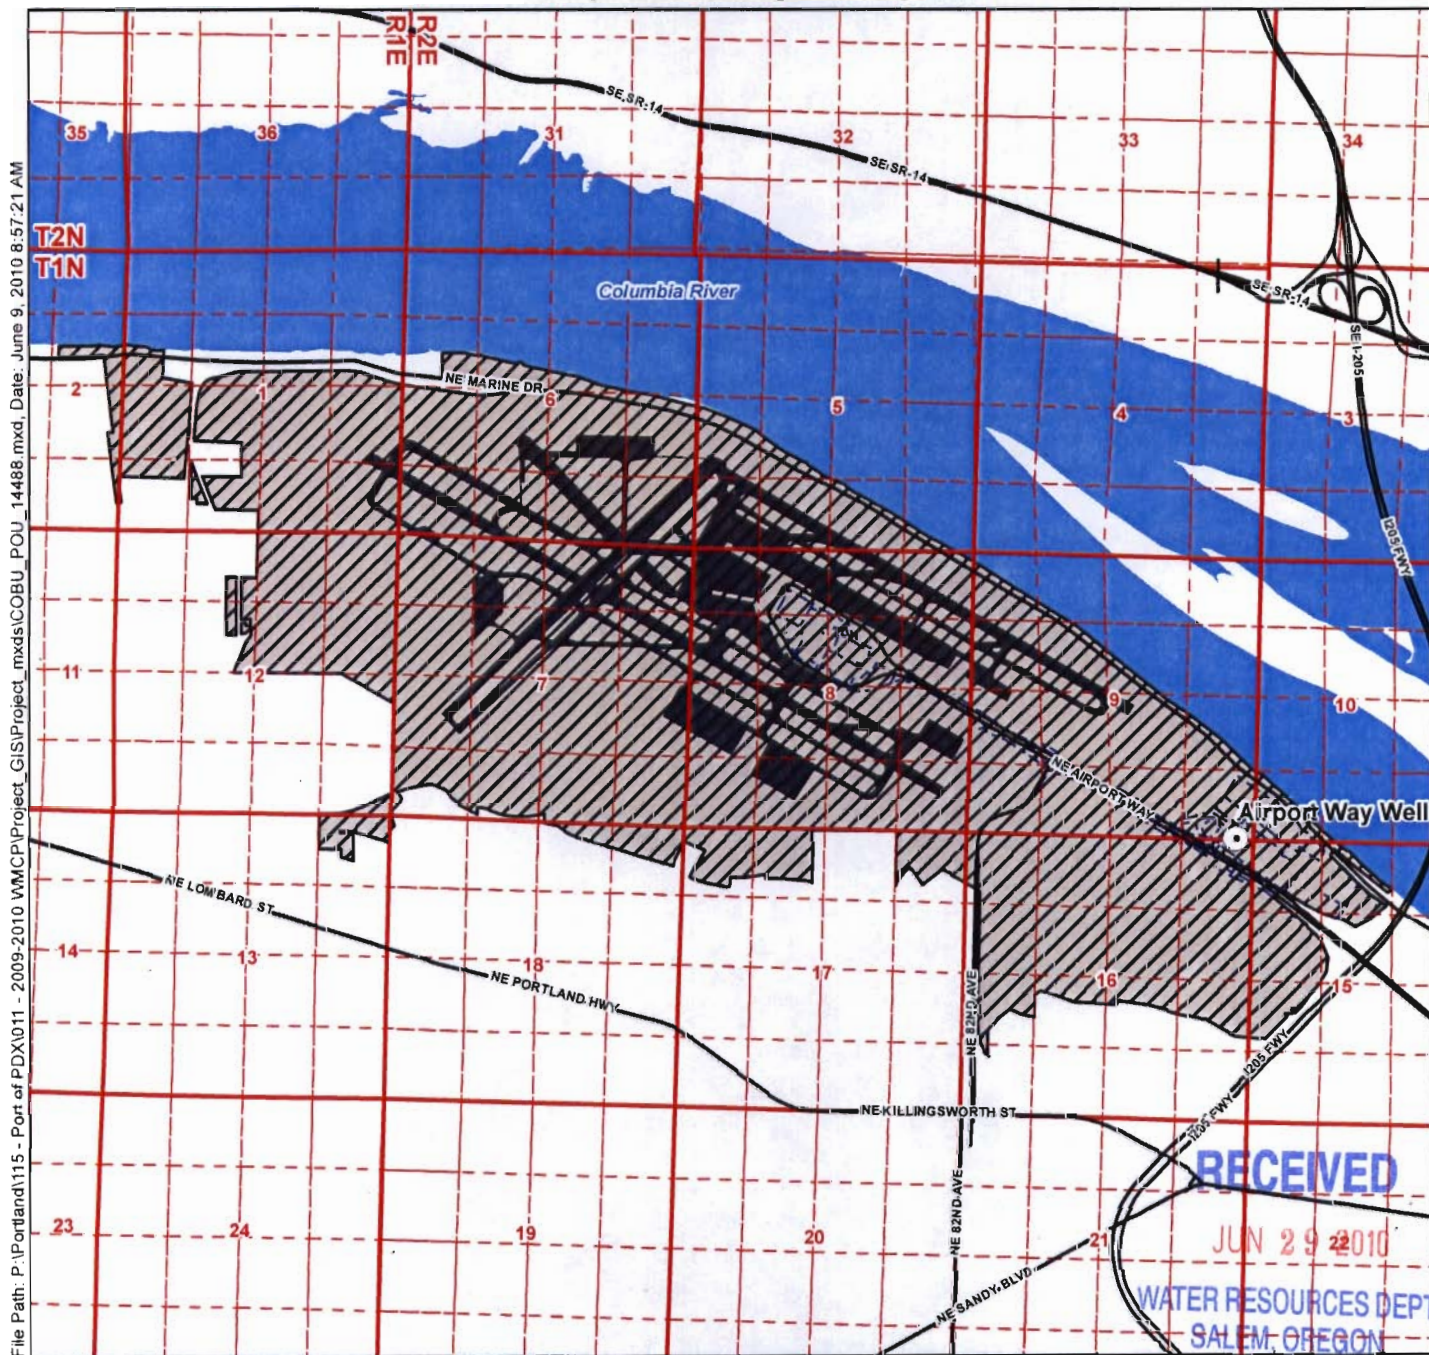


File Path: P:\Portland\115 - Port of PDX\011 - 2009-2010 VMCP\Project_GIS\Project_mxd\COBU_POU_14488.mxd, Date: June 9, 2010 8:57:21 AM

LEGEND

- Point of Appropriation (POA)
- ▨ Place of Use (POU)
- Water System Mainlines
- Major Roads
- Waterbodies


Certified Water Rights Examiner Stamp

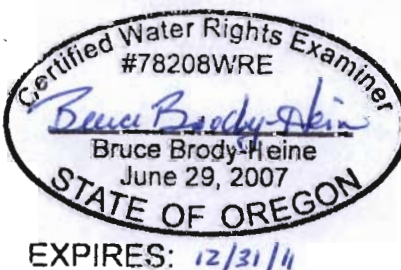


Disclaimer
 This map was prepared for the purpose of identifying the location of a water right only and it is not intended to provide legal dimensions or location of property ownership lines.

Map Information

Date: June 9, 2010
 Projection: Oregon State Plane North
 Datum: North American Datum 1983
 Data Sources: METRO
 Prepared By: GSI Water Solutions, Inc.

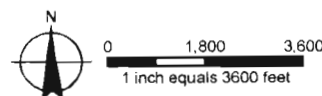

Claim of Beneficial Use Map
Point of Appropriation
Port of Portland
 Multnomah County, Oregon
 Permit G-13387, Application G-14488
 Section 9, Township 1 North, Range 2 East (W.M.)

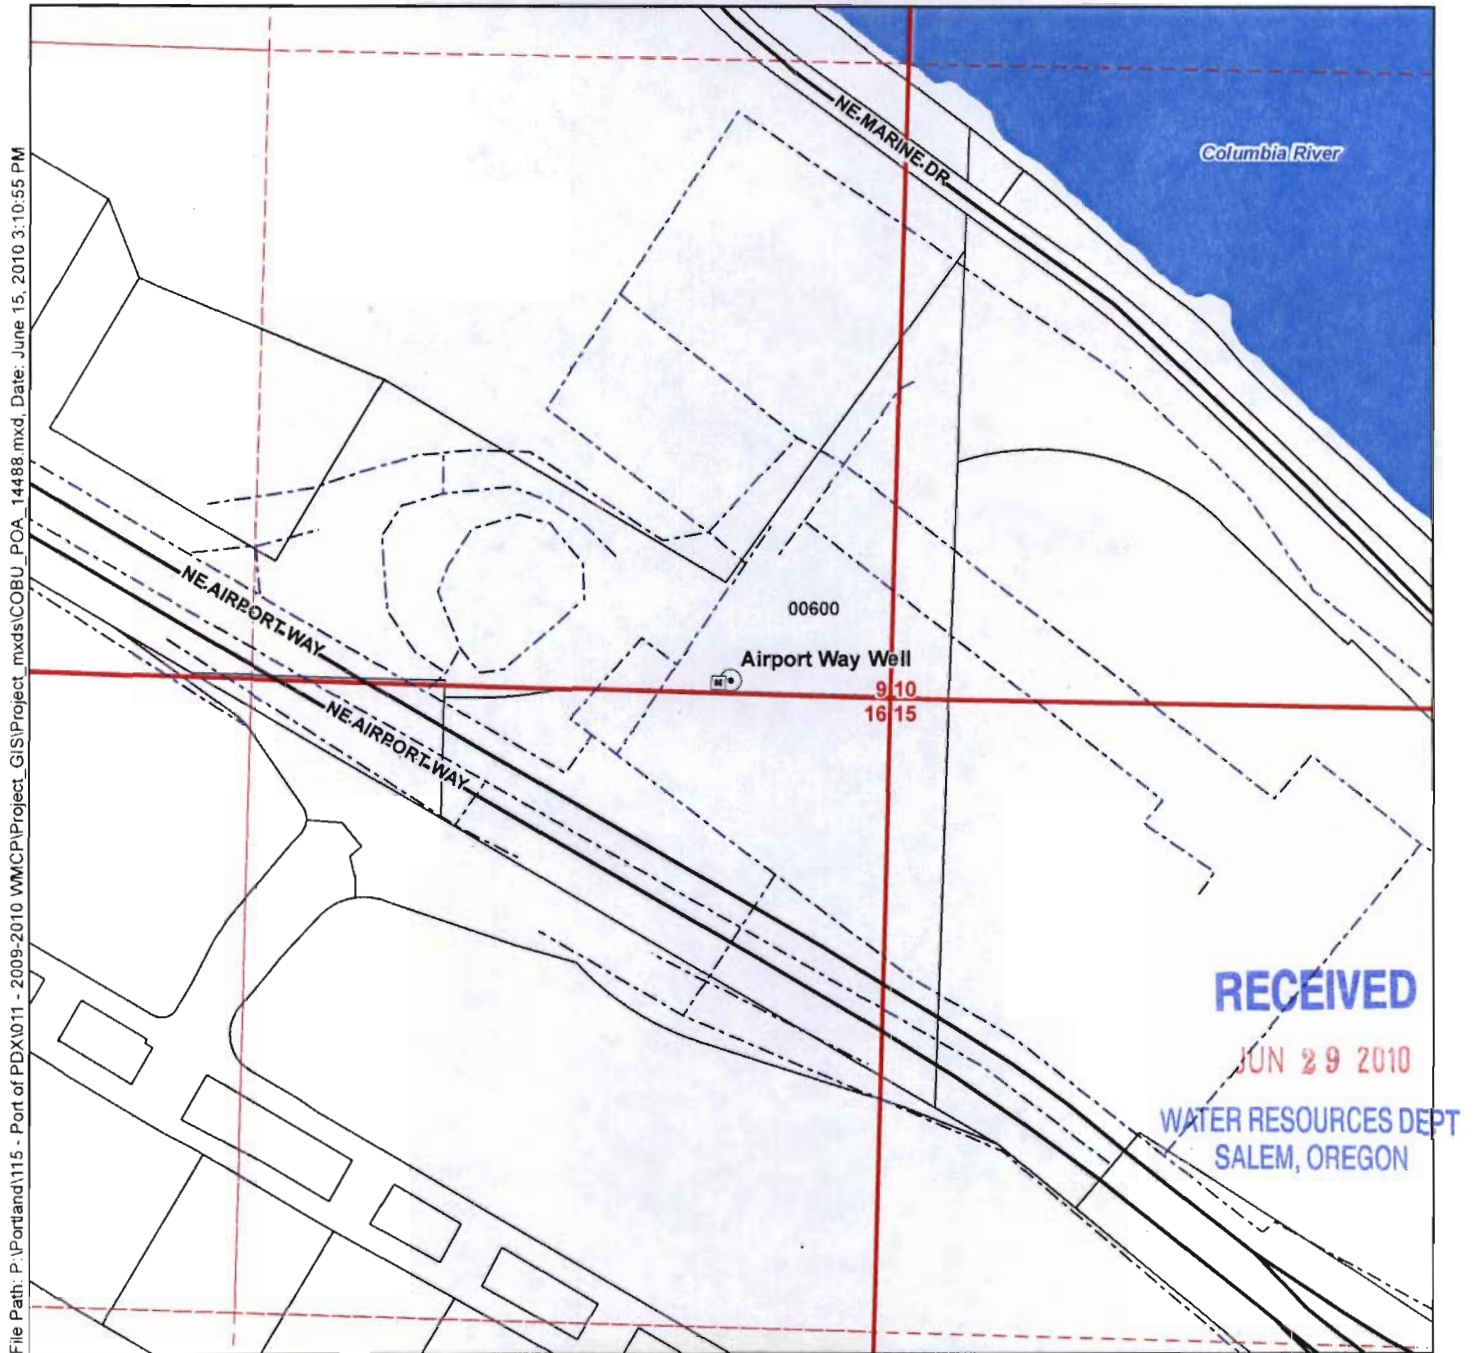

File Path: P:\Portland\115 - Port of PDX\011 - 2009-2010 WMC\Project_GIS\Project_mxd\COBU_POA_14488.mxd, Date: June 15, 2010 3:10:55 PM

LEGEND

- Point of Appropriation (POA)
- Water Meter
- Water System Mainlines
- Taxlots
- Major Roads
- Waterbodies


POA Location Description

Located 28 feet North and 335 feet West from the SE corner of Section 9, Township 1 North, Range 2 East (W.M.) being within taxlot 00600

Water Meter Location Description

Located in a below-ground vault approximately 24 feet West of well

Certified Water Rights Examiner Stamp

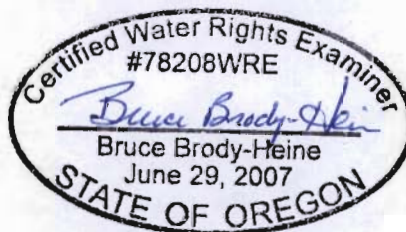

EXPIRES: 12/31/11

Disclaimer

This map was prepared for the purpose of identifying the location of a water right only and it is not intended to provide legal dimensions or location of property ownership lines.

Map Information

Date: June 15, 2010
 Projection: Oregon State Plane North
 Datum: North American Datum 1983
 Data Sources: METRO
 Prepared By: GSI Water Solutions, Inc.



0 200 400
 1 inch equals 400 feet

