


RECEIVED


SEP 18 1997

WATER RESOURCES DEPT.  
SALEM, OREGON

T 3 S R 38 E

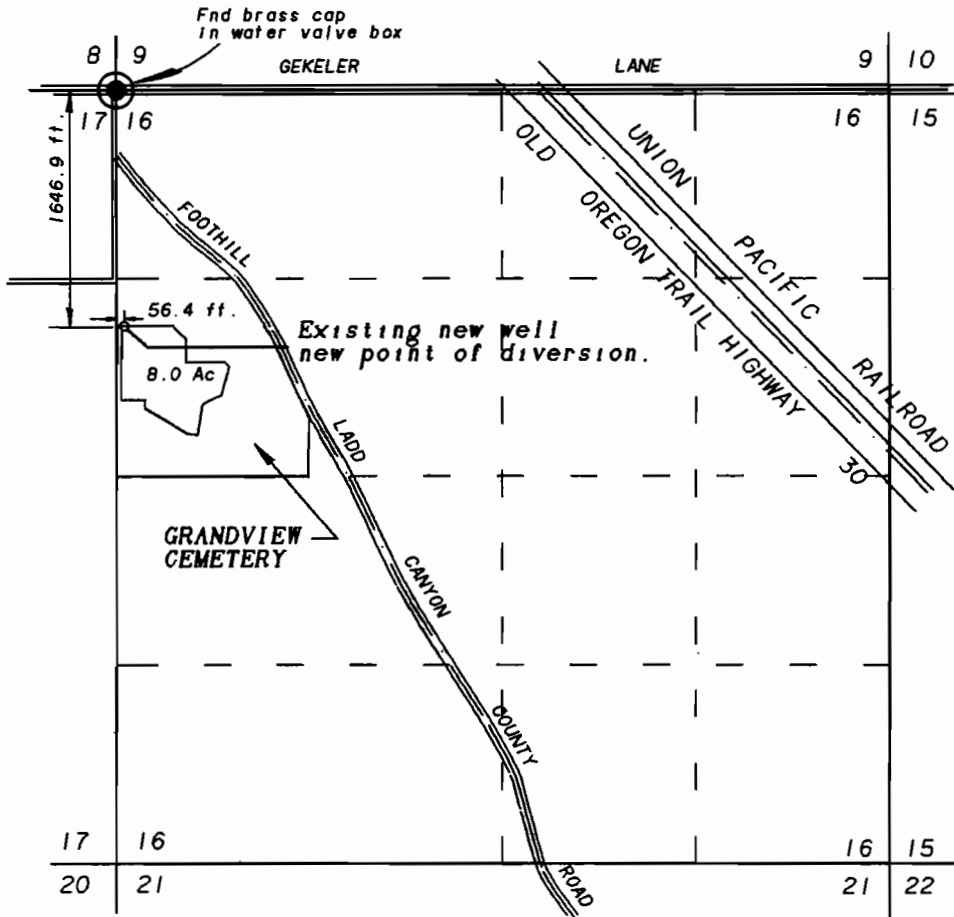

SCALE 1" = 1320'

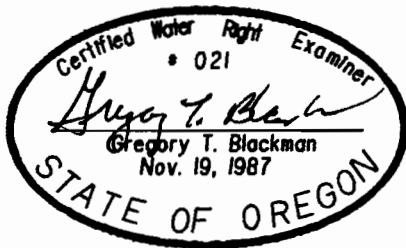

**FINAL PROOF MAP FOR  
CHANGE IN POINT OF  
DIVERSION  
FOR T- 7416**

FOR  
LAGRANDE CEMETERY  
MAINTENANCE DISTRICT

BY  
BAGETT - GRIFFITH & BLACKMAN  
2006 ADAMS AVENUE  
LAGRANDE, OREGON 97850

NOTE: The preparation of this map was for the purpose of identifying the location of the proposed water right and has no intent to provide dimensions or location of property ownership lines. Location information shown hereon was furnished by the applicant.

SEPTEMBER 3, 1997

APPLICATION NO. T-7416

PERMIT NUMBER \_\_\_\_\_