

T. 9 S., R. 4&5 W., W.M.

RECEIVED
MAY 5 1997

I certify that the information I have provided in this Final Proof is an accurate representation of the actual water use and is true and correct to the best of my knowledge. It is to be used for the purpose of identifying the location of water right only and is not intended to provide legal dimensions or locations of property ownership lines.


WATER RESOURCES DEPT
SALEM, OREGON

Matt Dunckel

Matt Dunckel, PLS 1942, C.W.R.E.



By: Matt Dunckel & Assoc.
19010 Baker Creek Road
McMinnville, OR 97128
Phone: 472-7904

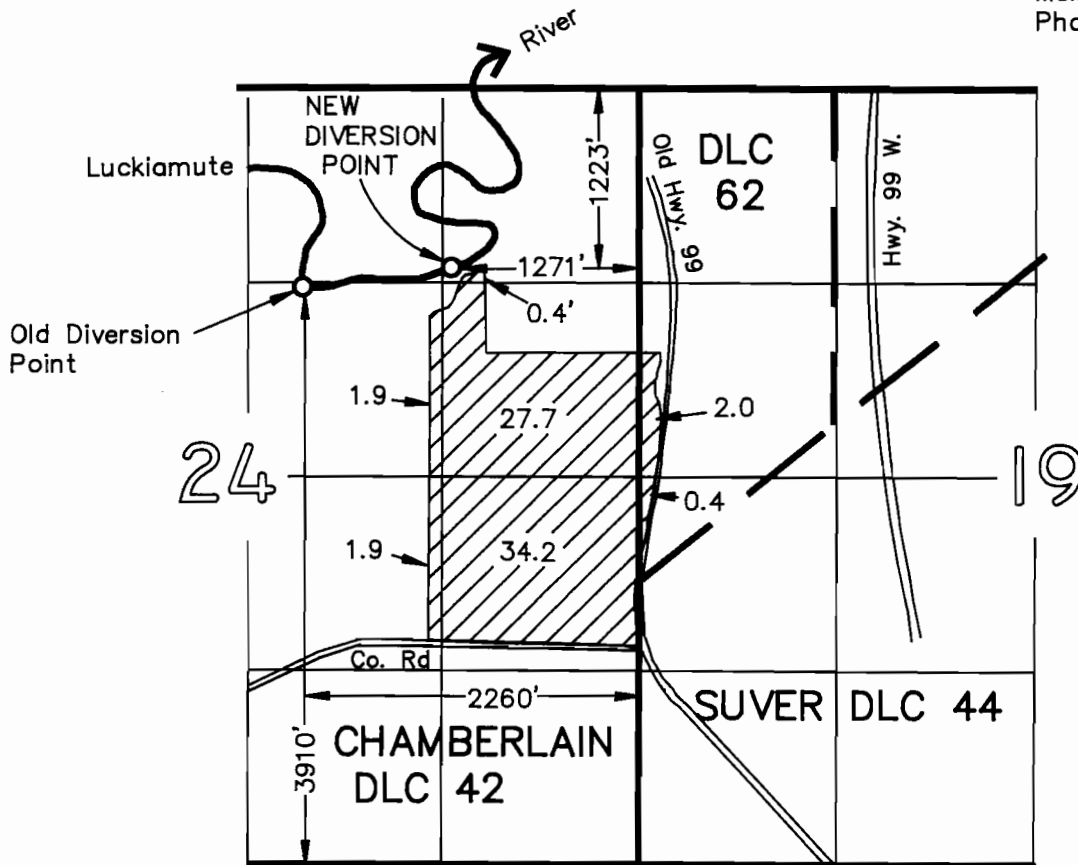

Scale: 1" = 1320'

FINAL PROOF SURVEY

UNDER

Transfer No. T-7342

IN NAME OF

LESTER I. VERSTEEG

Surveyed April 9, 1997