



Twp. 13 S., Rng. 4 W., WM.

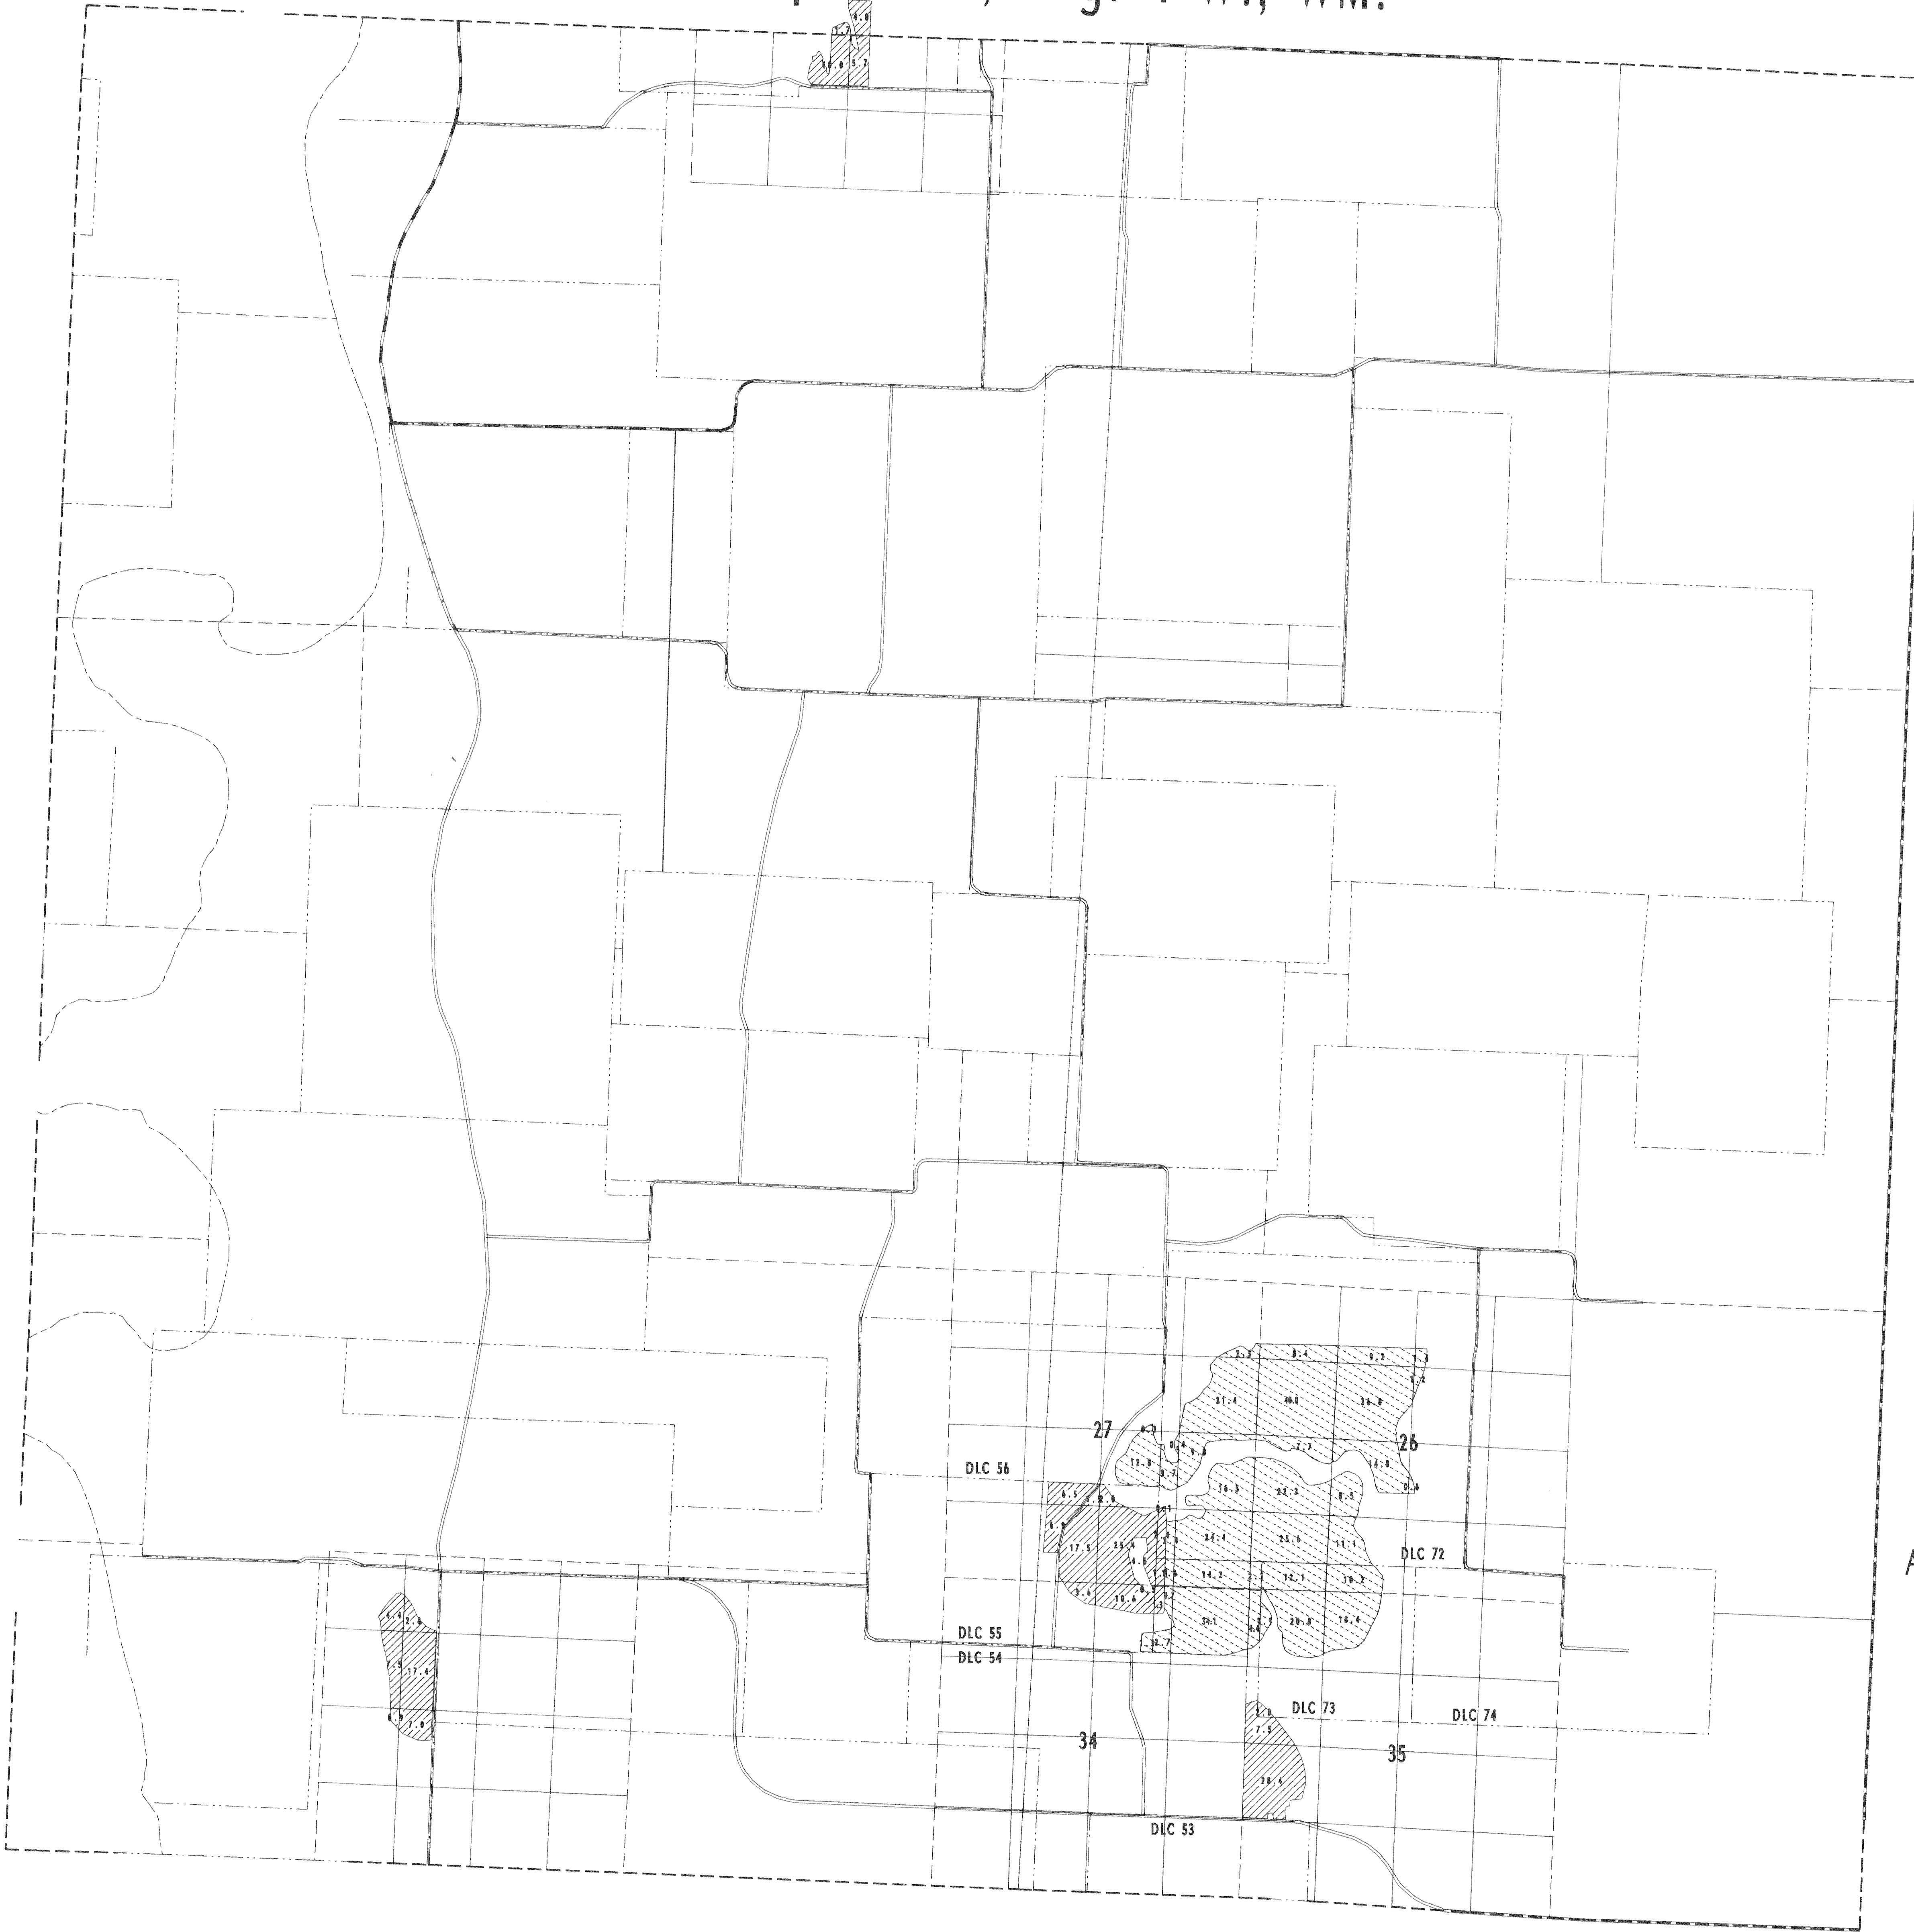

LEGEND

- Permit 50921
- Permit 37877
- Permit 42759
- Permit 43710
- Permit 45980
- Certificate 51589
- Certificate 82146
- Certificate 82281

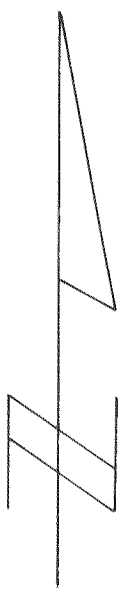

SCALE 1" = 1320'

### FINAL PROOF SURVEY


UNDER

Application	49527	Permit	37877
	55400		42759
	57947		43710
	58932		45980
	68824		50921

IN NAME OF  
MUDDY CREEKS IRRIGATION PROJECT

Surveyed 1993 By R.W.Klassen

Twp. 15 S., Rng. 4 W., WM.

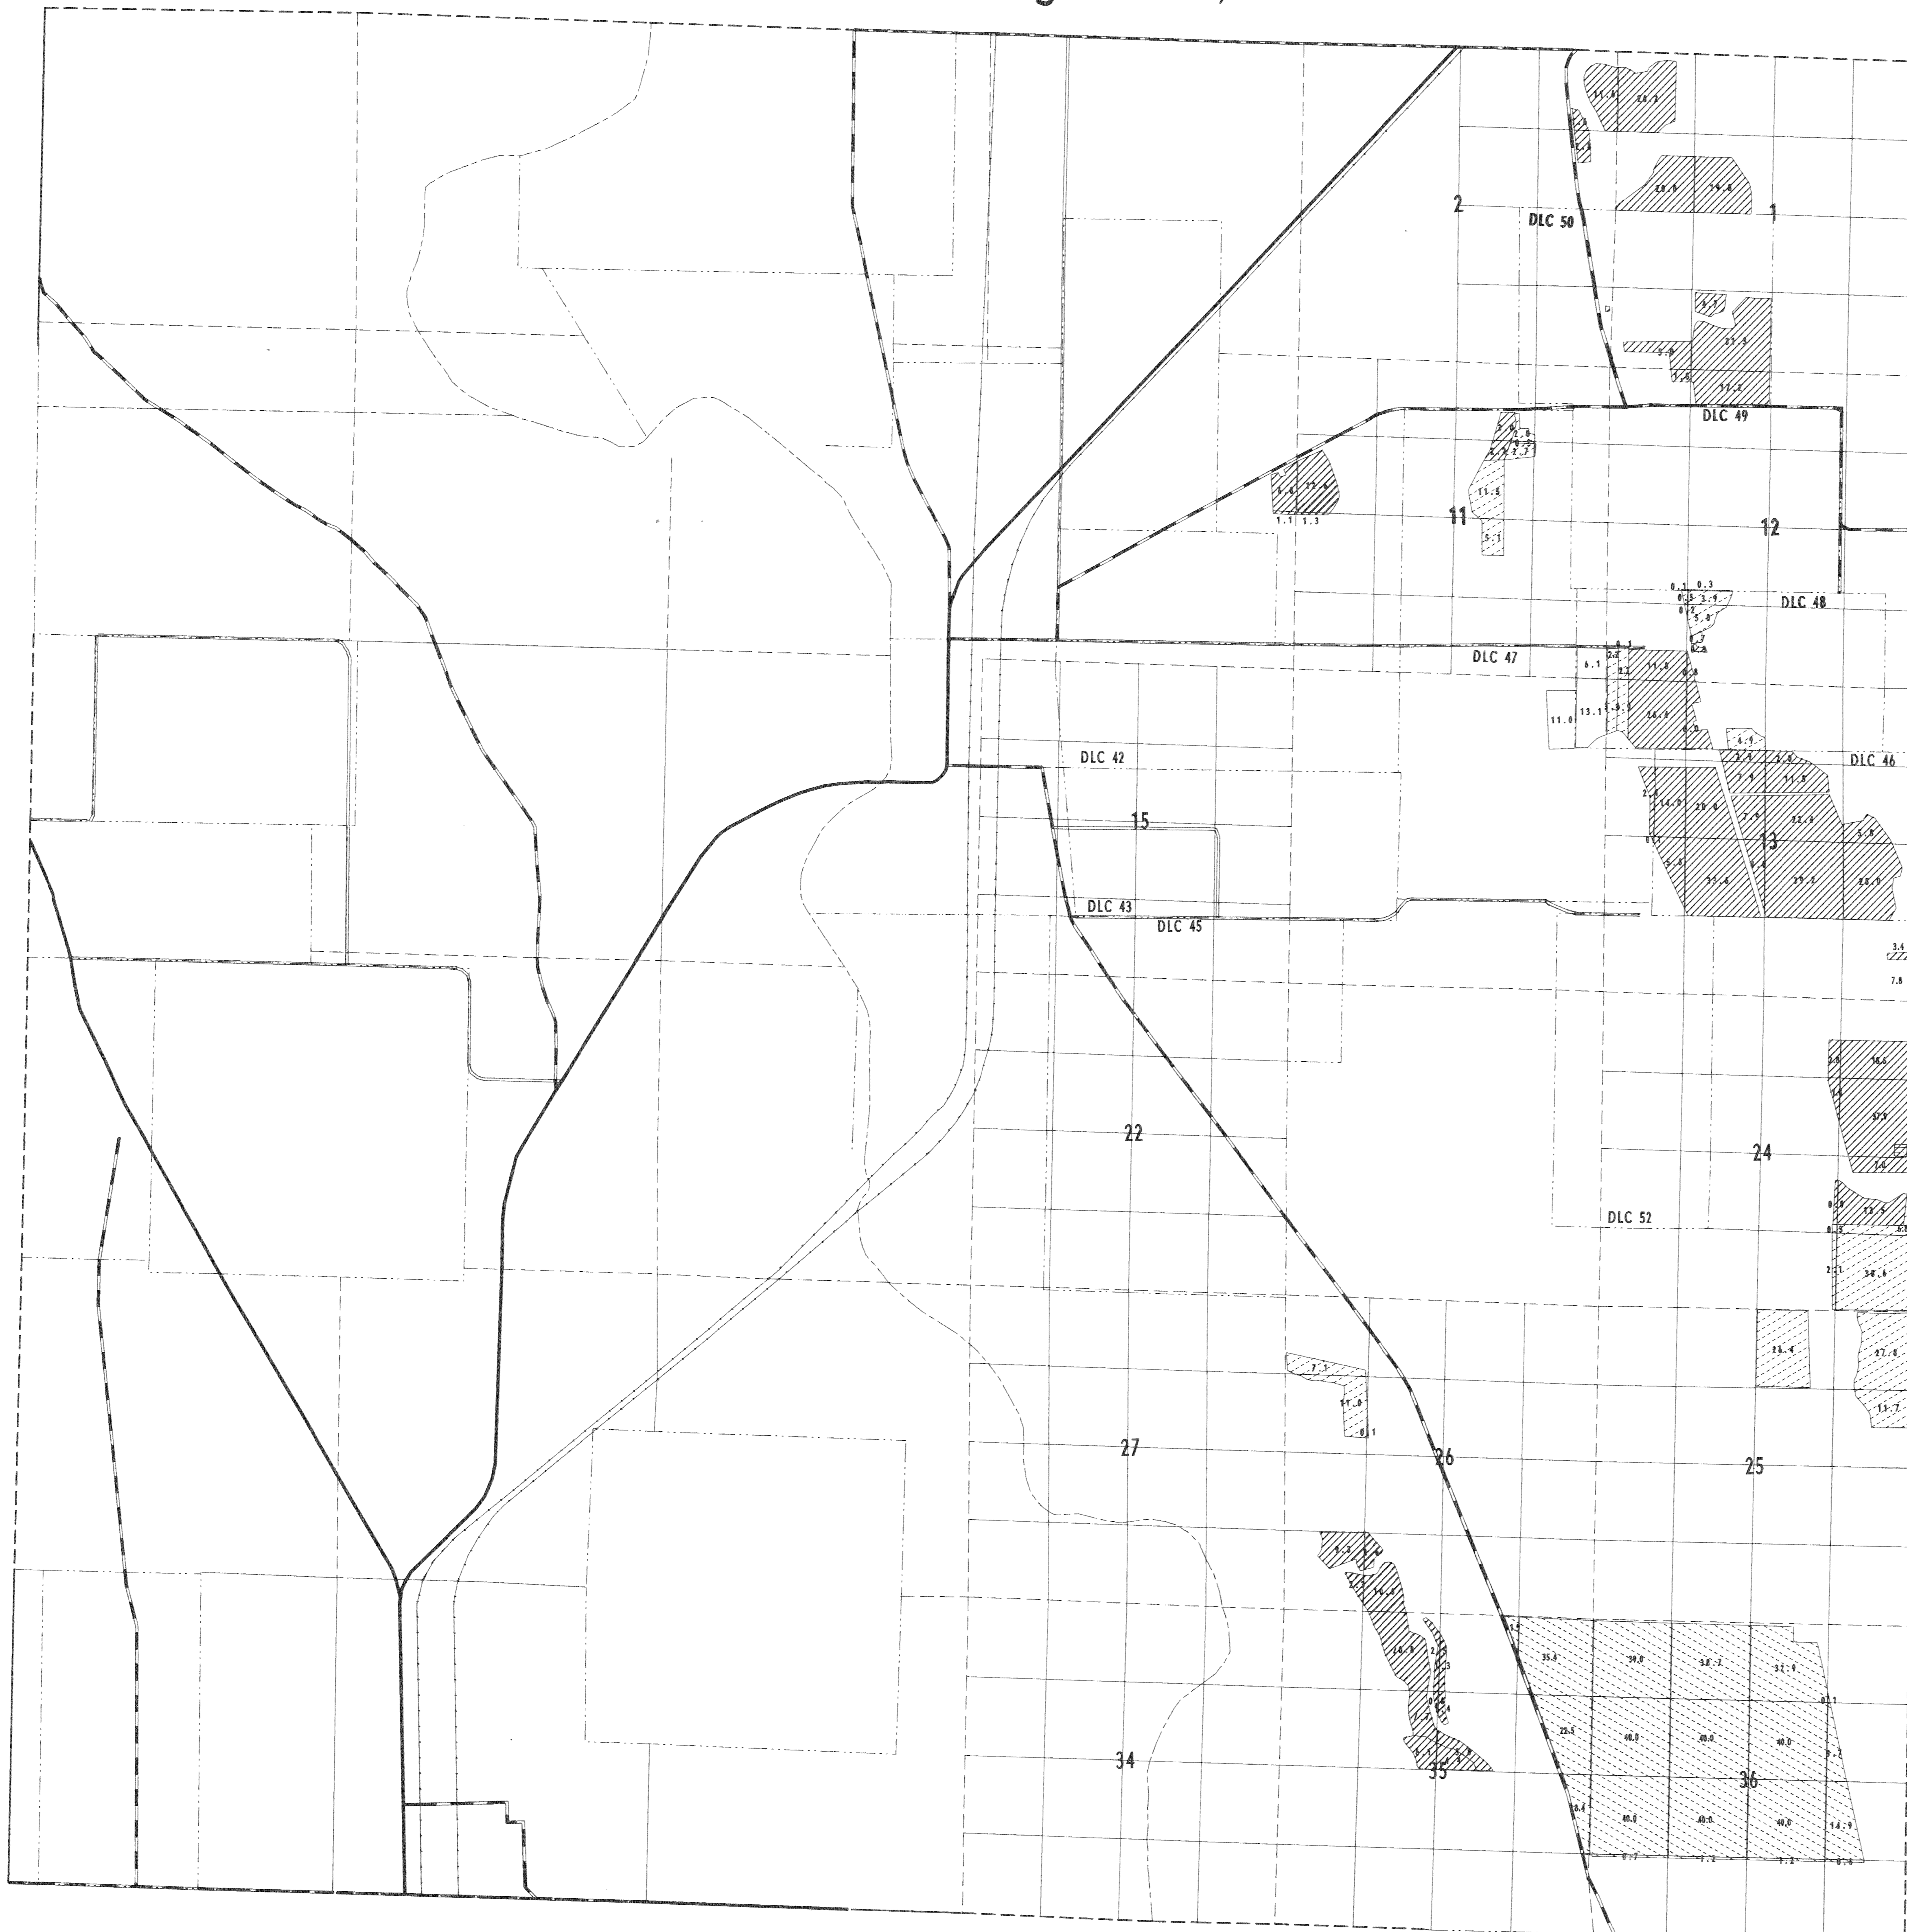

LEGEND

- Permit 50921
- Permit 37877
- Permit 42759
- Permit 43710
- Permit 45980
- Certificate 51588
- Certificate 62148
- Certificate 62281



SCALE 1" = 1320'

FINAL PROOF SURVEY  
UNDER


Application 49527	Permit 37877
55400	42759
57947	43710
58932	45980
68824	50921

IN NAME OF  
MUDDY CREEKS IRRIGATION PROJECT





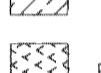
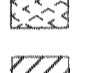
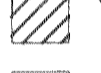

Surveyed 1993 By R.W.Klassen


Date/Time: 8/12/1994 3:06 PM  
 Plotfile: /arcdata/assn/15s/15s.mfp

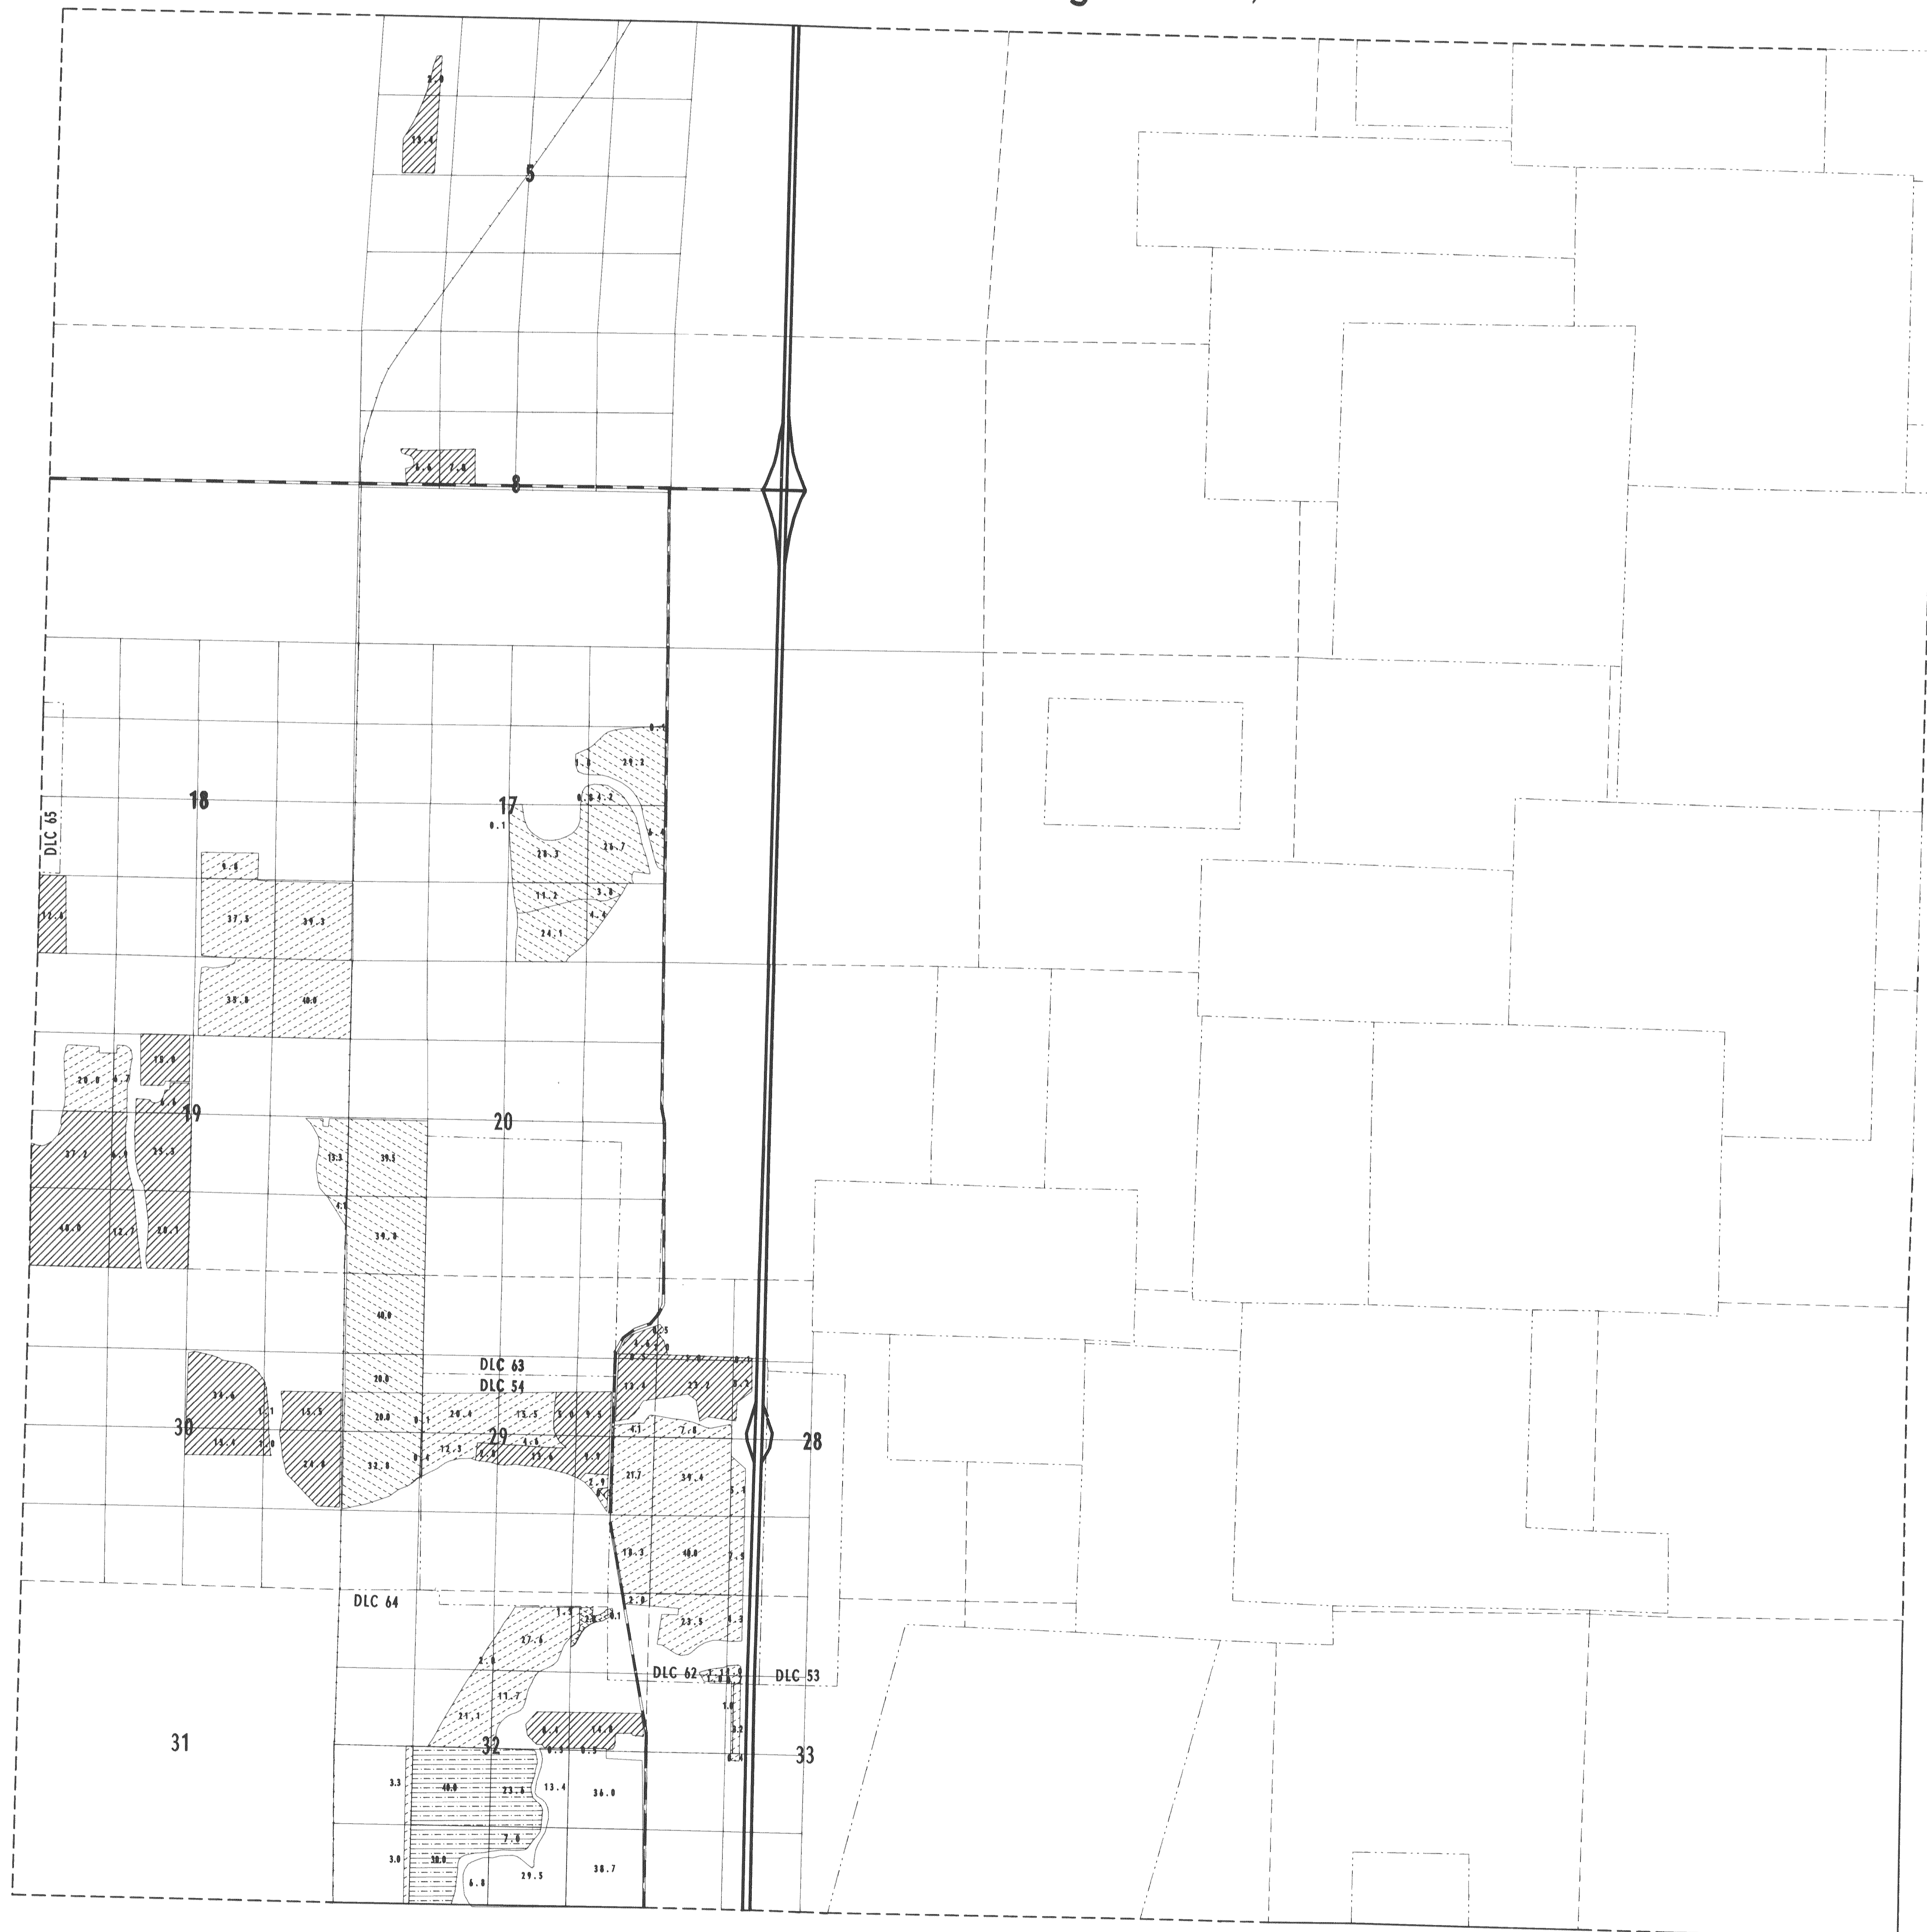Twp. 15 S., Rng. 3 W., WM.



LEGEND

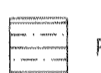-  Permit 50921
-  Permit 37877
-  Permit 42759
-  Permit 43710
-  Permit 45980
-  Certificate 51599
-  Certificate 62148
-  Certificate 62201

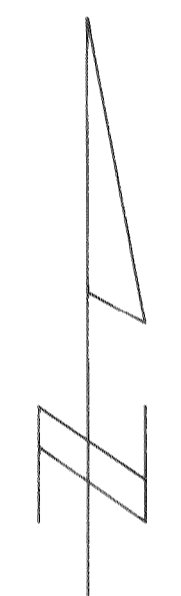

SCALE 1" = 1320'

**FINAL PROOF SURVEY**  
UNDER

Application 49527	Permit 37877
55400	42759
57947	43710
58932	45980
68824	50921

IN NAME OF  
**MUDDY CREEKS IRRIGATION PROJECT**

Surveyed 1993 By R.W.Klassen