


FINAL PROOF MAP T-8950  
 NE1/4NE1/4, SEC. 4, T.39S., R.3W., W.M.  
 JACKSON COUNTY, OREGON  
 FOR  
 JOHN RINALDI JR. AND BONNIE RINALDI  
 375 HAMILTON ROAD  
 JACKSONVILLE, OR 97530



Scale: 1"=400'  
 Date: August 30, 2006  
 Revised: August 31, 2010

LEGEND

- Found Survey Monument
- Denotes Building
- ▨ Denotes Area Under Special Order Volume 64, Pages 453-456, Priority Date Sept. 1, 1857
- Ⓜ Denotes Flow Meter

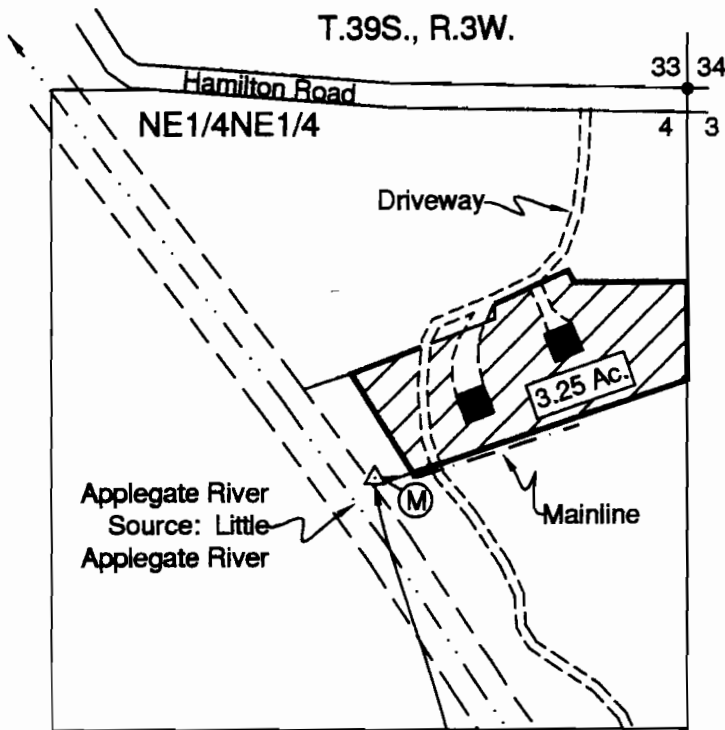

Point of Diversion No. 1  
 800' South and 650' West  
 of the Northeast Corner,  
 Section 4.  
 Fish Screen at  
 Point of Diversion



**RECEIVED**

HAROLD L. CENTER  
 2604 David Lane  
 Medford, OR. 97504  
 Phone 541-535-6108  
 Oregon Certificate No. 152  
 Certificate Renewal Date: 12/31/2011

SEP 07 2010


WATER RESOURCES DEPT  
 SALEM, OREGON

This map was prepared for the purpose of identifying the location of a water right only and is not intended to provide legal dimensions or location of property ownership.

FINAL PROOF MAP T-8950  
 NE1/4NE1/4, SEC. 4, T.39S., R.3W., W.M.  
 JACKSON COUNTY, OREGON  
 FOR  
 ROBERT W. AND LINDA MURPHY  
 375 HAMILTON ROAD  
 JACKSONVILLE, OR 97530



Scale: 1"=400'  
 Date: August 30, 2006

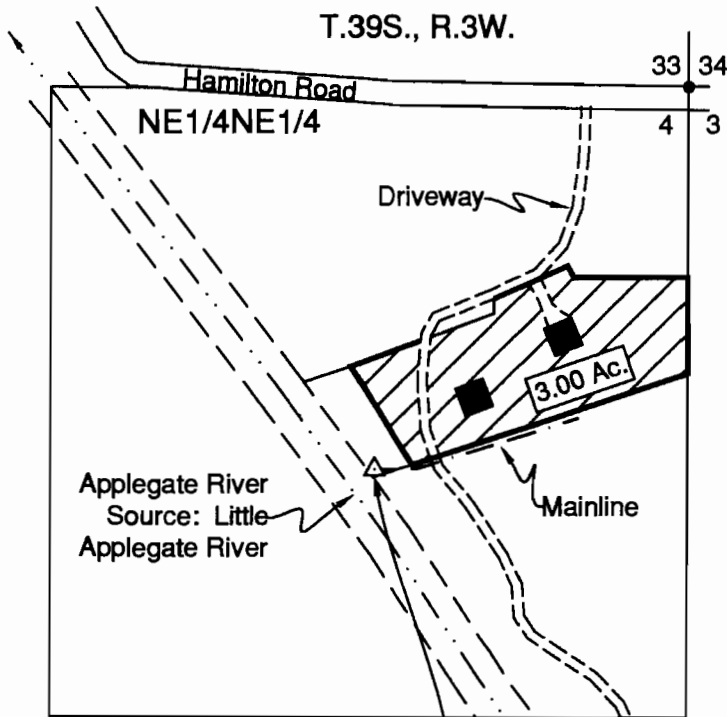

Point of Diversion No. 1  
 800' South and 650' West  
 of the Northeast Corner,  
 Section 4.  
 Fish Screen at  
 Point of Diversion


**LEGEND**

- Found Survey Monument
- Denotes Building
- ▨ Denotes Area Under Special Order Volume 64, Pages 453-456, Priority Date Sept. 1, 1857




HAROLD L. CENTER  
 2604 David Lane  
 Medford, OR. 97504  
 Phone 541-535-6108  
 Oregon Certificate No. 152  
 Certificate Renewal Date: 12/31/2007

This map was prepared for the purpose of identifying the location of a water right only and is not intended to provide legal dimensions or location of property ownership.

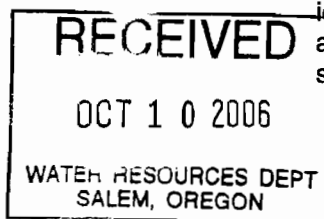

# T 39 S, R 3 W, W.M.

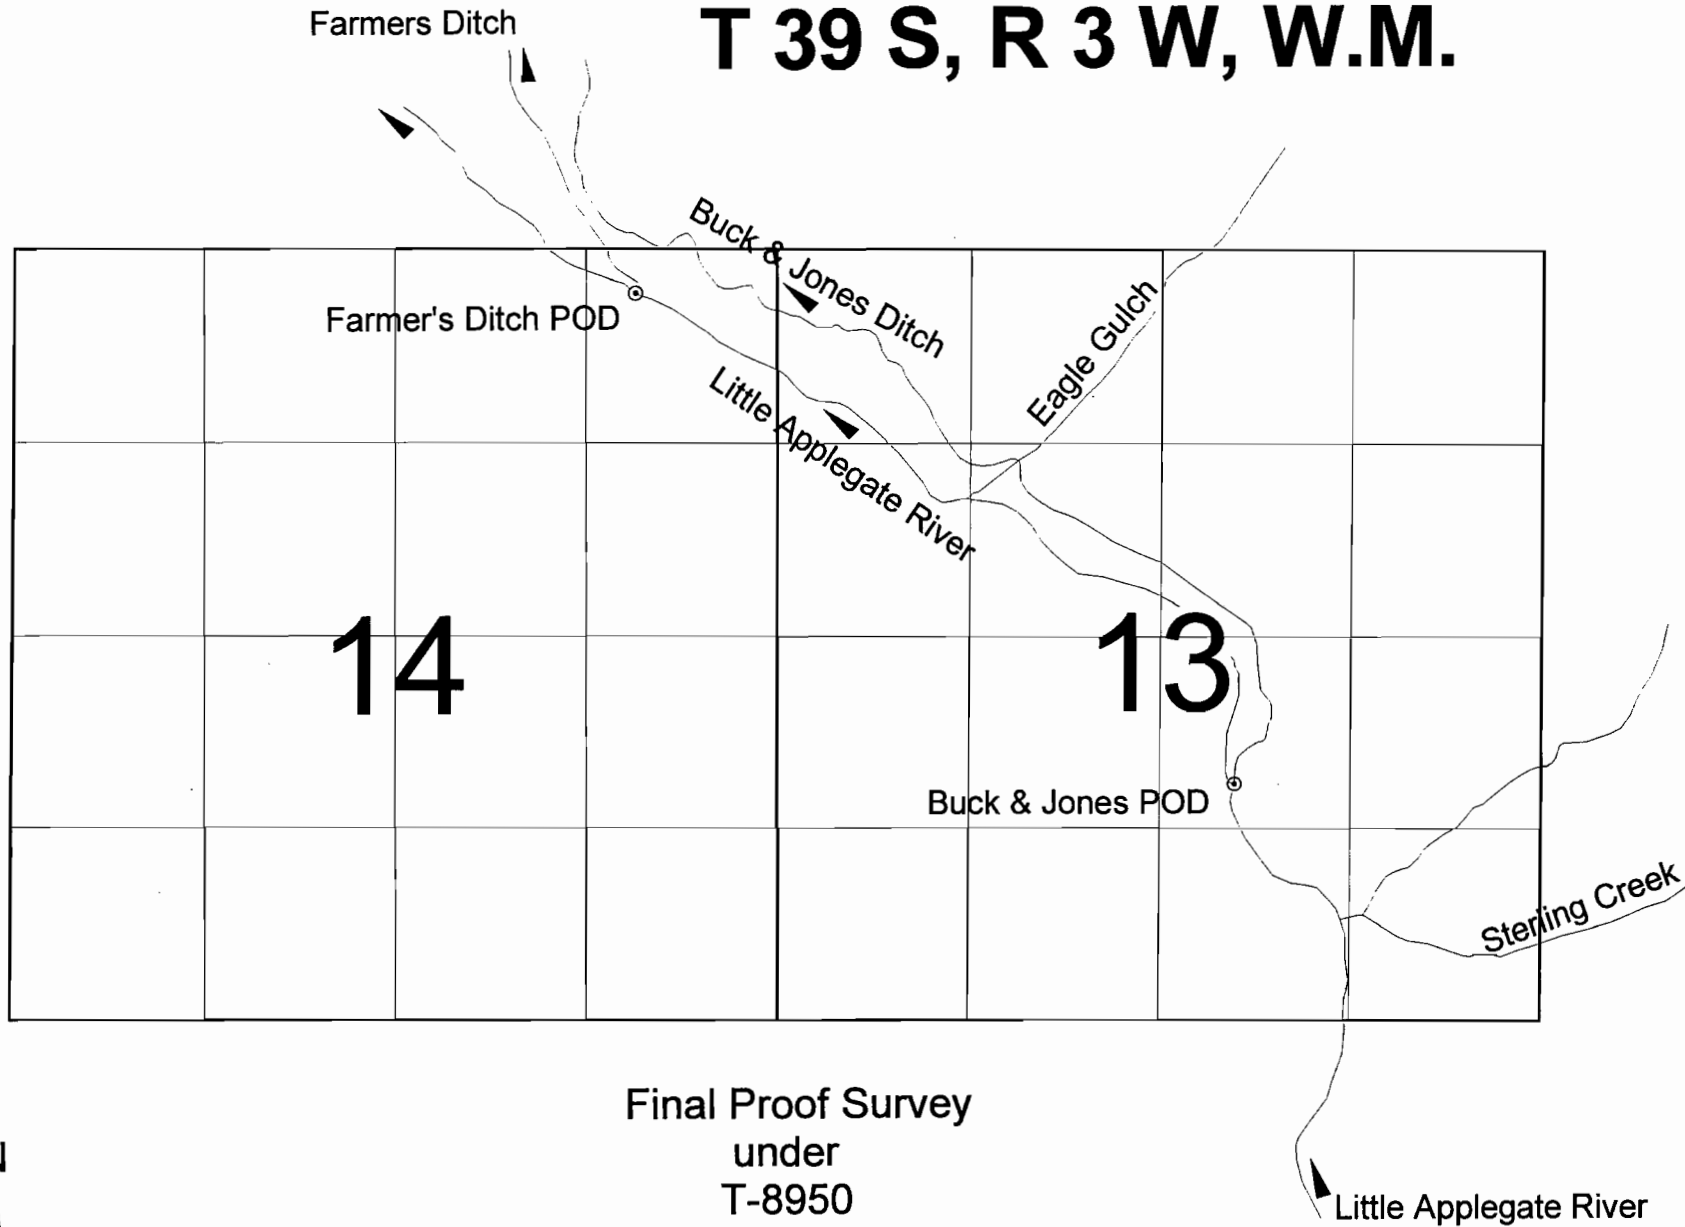

Farmer's Ditch POD - GPS coordinates: Latitude 42.18400, Longitude -123.0174  
Buck & Jones Ditch POD - GPS coordinates: Latitude 42.17508, Longitude -123.0018

