


AUG - 2 1996

WATER RESOURCES DEPT.  

NE CORNER SEC. 4  
T.3 N., R.34 E., W.M.

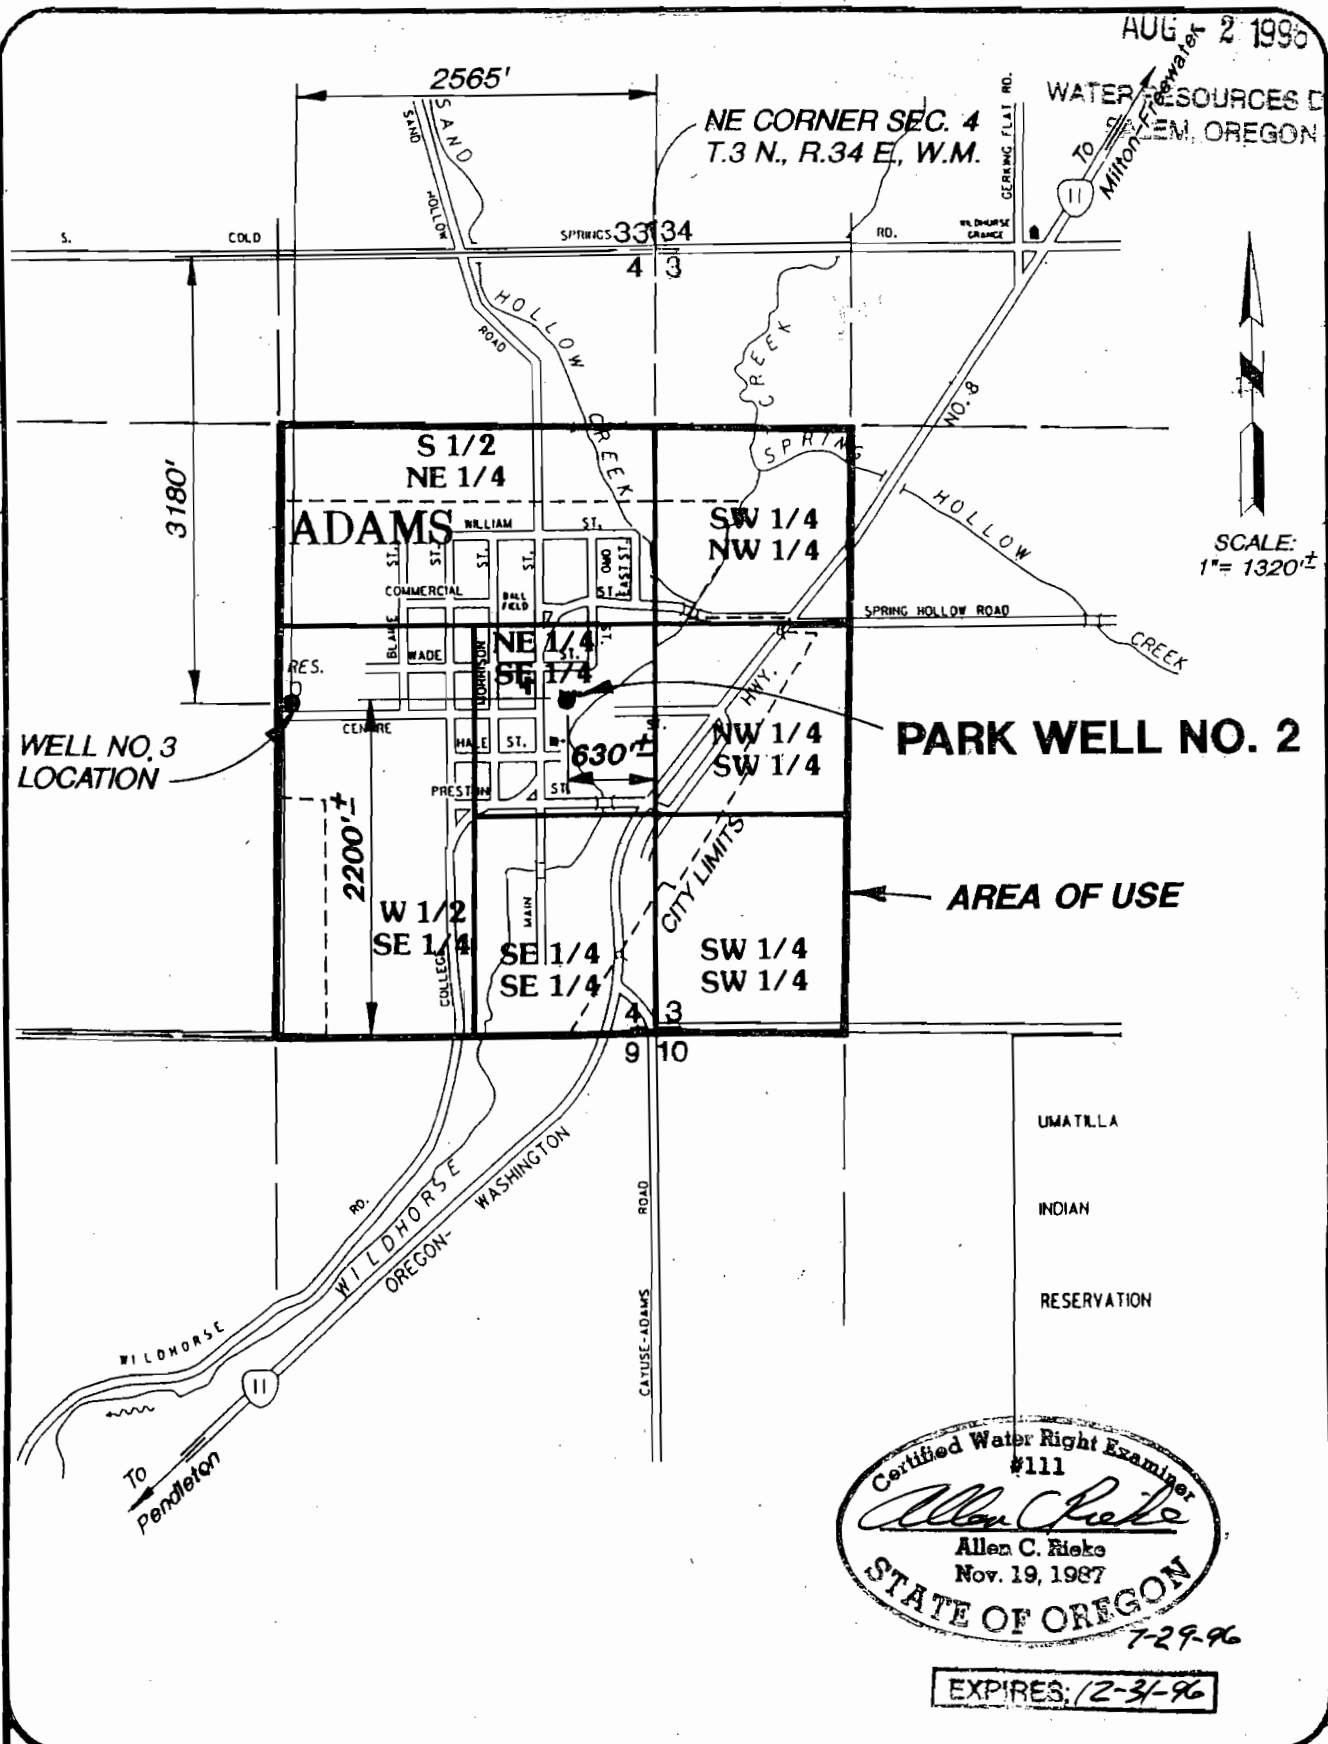

PARK WELL NO. 2

WELL NO. 3  
LOCATION

AREA OF USE

UMATILLA  
INDIAN  
RESERVATION

Certified Water Right Examiner  
#111  
*Allen C. Fieko*  
Allen C. Fieko  
Nov. 19, 1987  
STATE OF OREGON

7-29-96

EXPIRES: 12-31-96