


T.6S., R.2W., W.M.

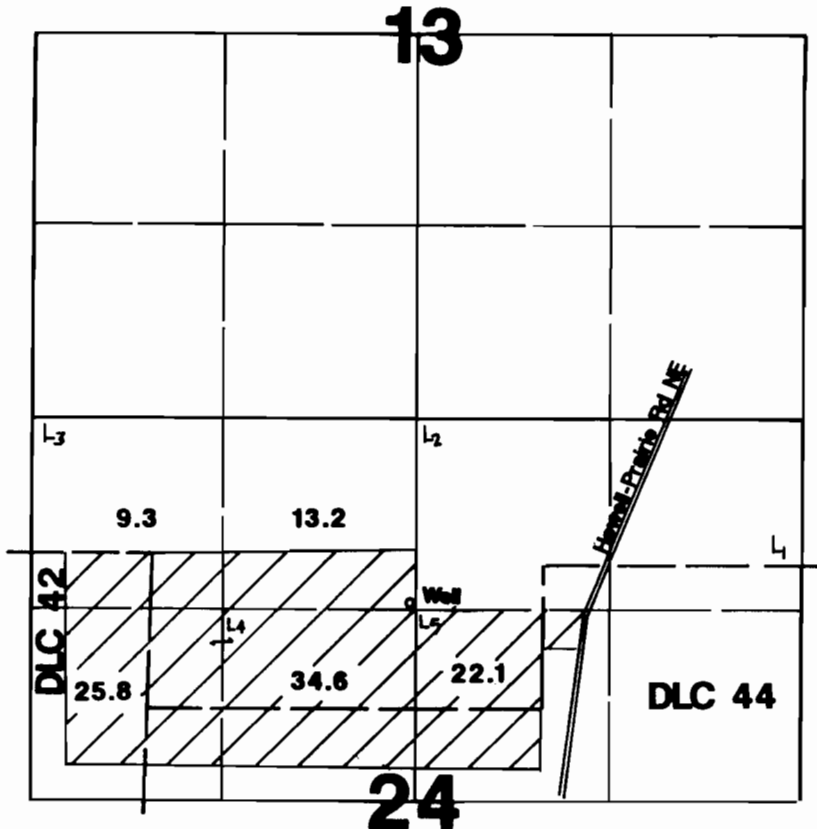

Well located 1325'N & 6'W of center of Section 24.



Final Proof Survey

Application #: G-13161 Permit #: G-12083

In Name Of

Clarence Schmidt

Surveyed on June 12, 1996 by James Grimm

THIS MAP WAS PREPARED FOR THE PURPOSE OF IDENTIFYING THE LOCATION OF A WATER RIGHT ONLY AND IS NOT INTENDED TO PROVIDE LEGAL DIMENSIONS OR LOCATION OF PROPERTY OWNERSHIP LINES.