


38-2-18


Mainwaring Property  
38S 2W 31 200

RESERVOIR LOCATED from  
CENTER SECTION 31  
1750 ft SOUTH  
830 ft WEST

Section  
31

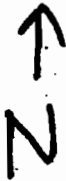

Scale  
1" = 1000'

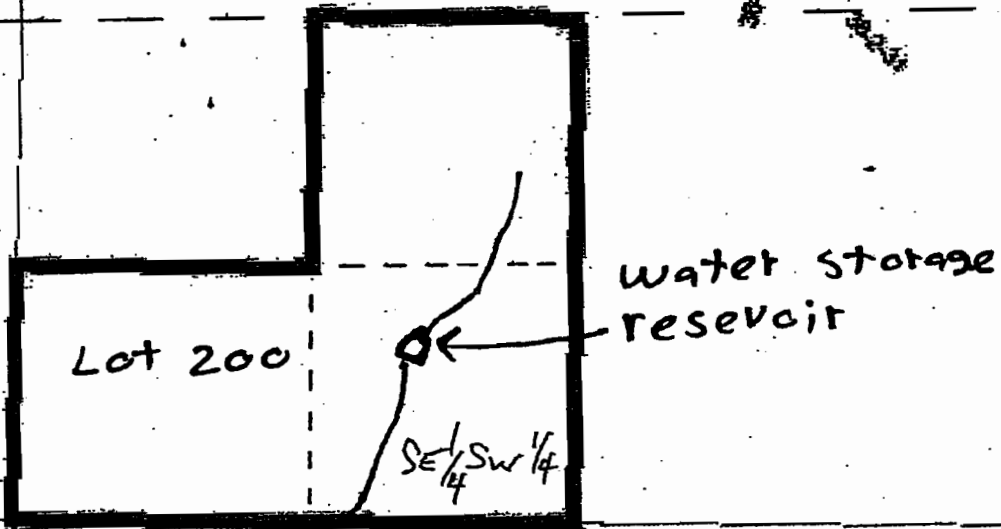

- Map M:  
 Apply:  
 Front Corner  
 Highlights  
 Tax Lot Or  
 City Limit  
 Ashland  
 Butte Falls  
 Central Po  
 Eagle Point  
 Gold Hill  
 Jacksonvill  
 Madford  
 Phoenix  
 Rogue Riv  
 Shady Cor  
 Talent

RECEIVED

MAY 24 2010

WATER RESOURCES DEPT  
SALEM, OREGON

RECEI

AUG 14

WATER RESOUR  
SALEM, OR

