


T. 25 & 26 S., R. 35 E., W.M.

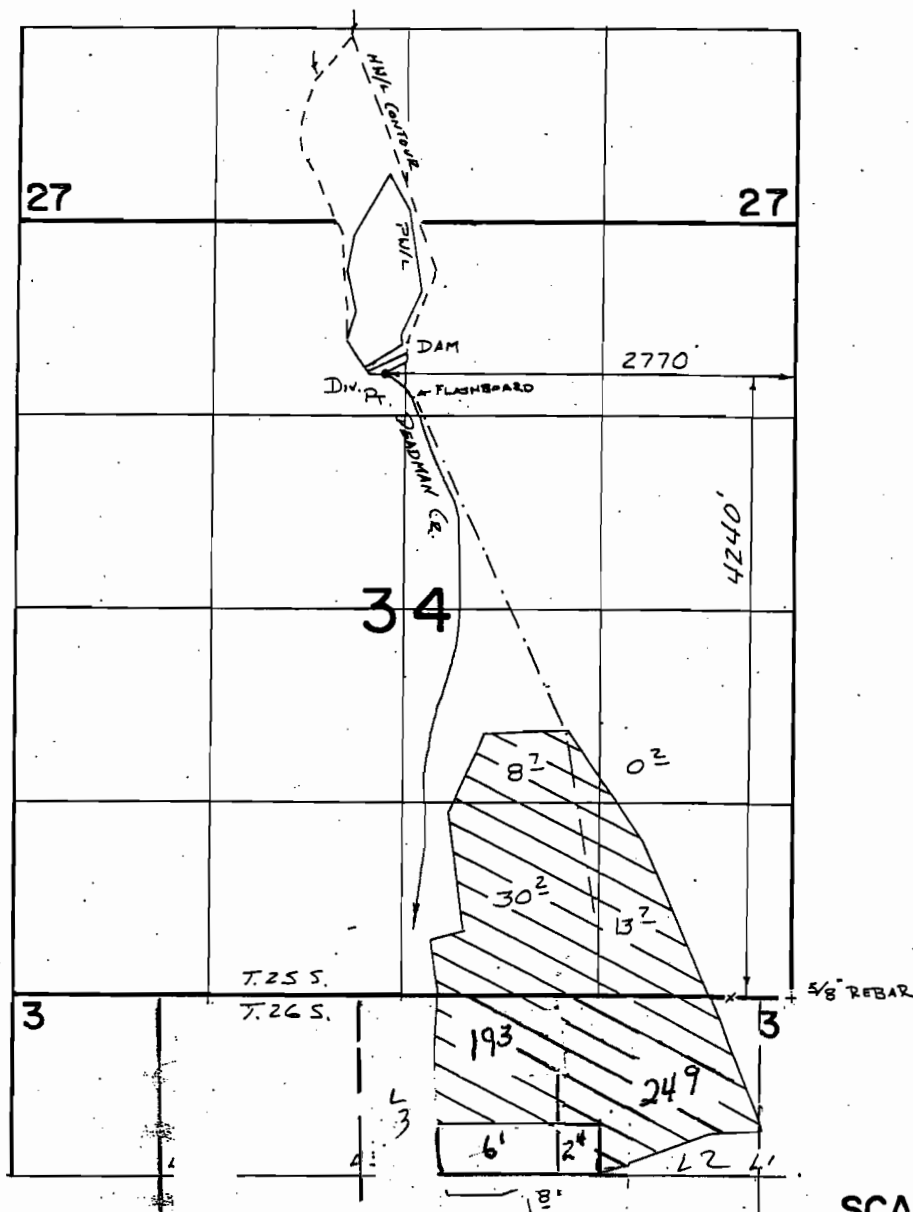

SCALE 1" = 1320'

FINAL P.L. OF S. VEY

UNDER

R-68661
R-65326
65327

R-10787
R-8899
47934

PER. 47934

Application No. Permit No.
IN NAME OF

JERRY A. & LINDA K. MILLER

Surveyed 5-8-1988, by T.M. WARREN

Modified by WENSTAFF
6-7-2010 JG