


T. 25 & 26 S., R. 35 E., W.M.

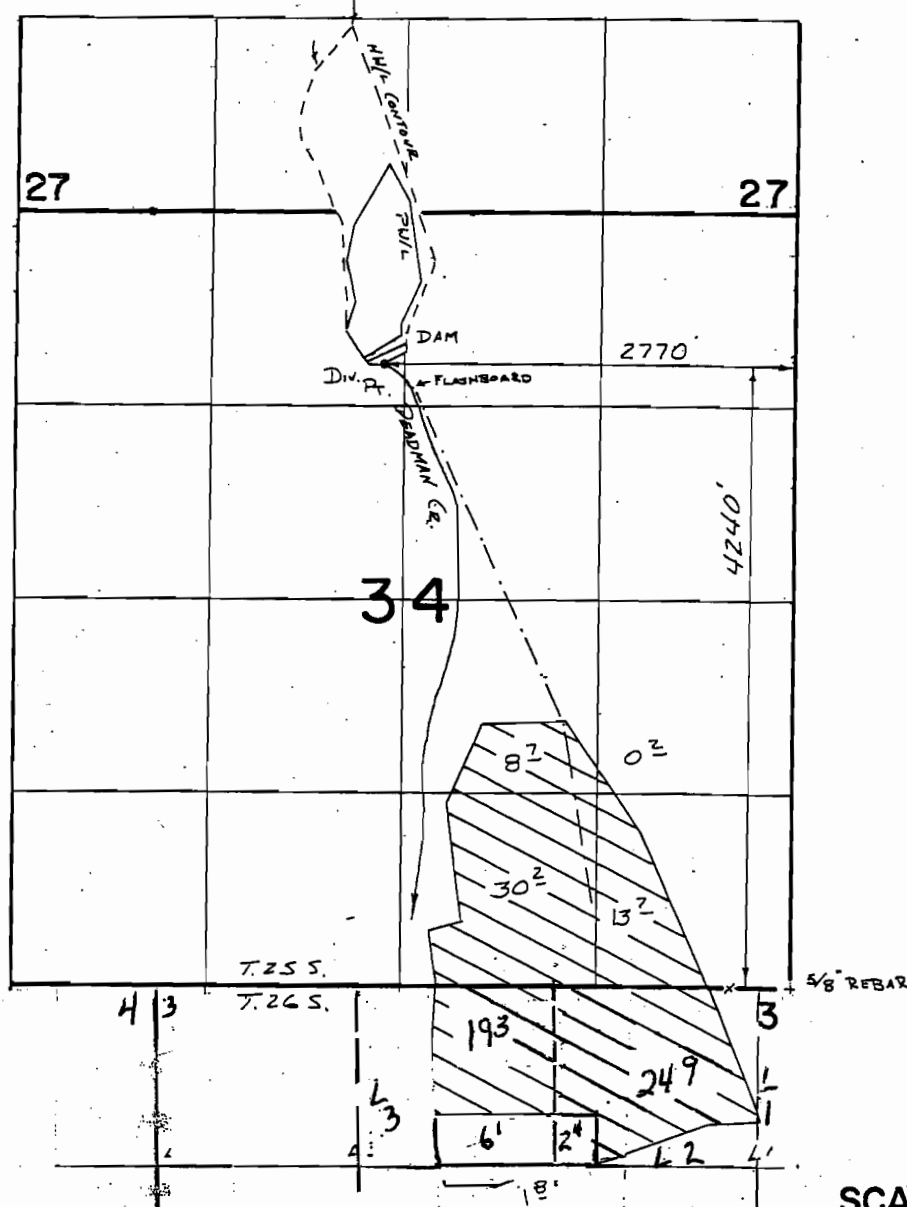

FINAL PLAN OF SITE

UNDER

R-68661
R-65326
65327

R-10787
R-8899
47934



Per. 47934

Application No. Permit No.
IN NAME OF

JERRY A. & LINDA K. MILLER

Surveyed 5-8-1988, by T.M. WARREN

Modified by WRO Staff,
6-7-2010 JCR