

RECORDED

WATER RIGHTS DIVISION  
SALEM, OREGON

T 25 S., R. 11 W. W.M.

FINAL PROOF SURVEY

SEC. 4 NE 1/4 NW 1/4

Transfer No. 6768


TO THE NAME OF

R. David & Ronda L. Amatore


Surveyed Aug. 20, 1994 by:

Scale: = 1" = 400'

Capacity of Irrigation System: .0379 CFS.

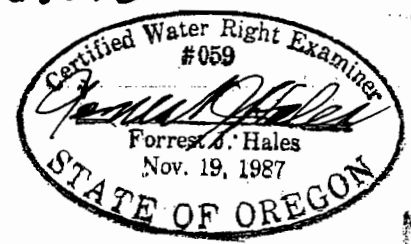

OAR 690-14-170-4 ... "the map is for the purpose of identifying the location of the water right only."

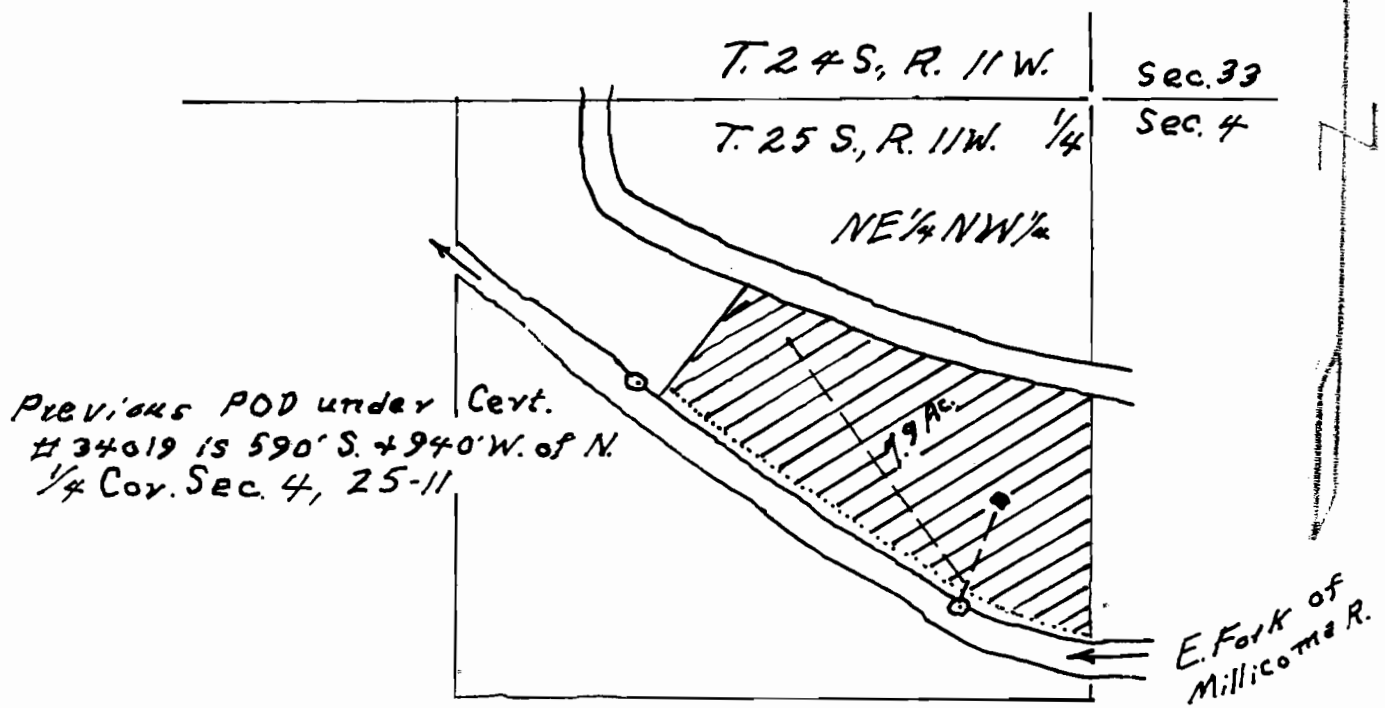

Previous POD under Cert. #34019 is 590' S. + 940' W. of N. 1/4 Cor. Sec. 4, 25-11

New P.O.D under Cert. # 34019 is 1061' S. + 282' W. of N. 1/4 Cor. S. 4, 25-11.