

SW1/4, SE1/4

SE1/4, SE1/4

RECEIVED 28 27
33 34

NOV 18 1998

WATER RESOURCES DIV.
SALEM, OREGON

NW1/4, NE1/4

NE1/4, NE1/4

CALC. FROM PROP. COR. TIES
NE COR. OF SW OF NE
SECTION 33

POINT OF DIVERSION
412 FEET SOUTH
142 FEET WEST
NE COR. OF SW OF NE
SECTION 33

BURNT HILL CREEK

SE1/4, NE1/4

SW1/4, NE1/4

THE PREPARATION OF THIS MAP WAS FOR THE PURPOSE OF IDENTIFYING
THE LOCATION OF THE PROPOSED WATER RIGHT AND HAS NO INTENT TO
PROVIDE DIMENSIONS OR LOCATION OF PROPERTY LINES.

FINAL PROOF SURVEY

APPLICATION S-80367

PERMIT #52988

IN THE NAME OF

CHARLES & DOROTHY CARPENTER

SW 1/4, NE 1/4, SECTION 33

T. 38 S., R. 14 W., W. M.

SURVEYED OCTOBER 22, 1998 BY BRYAN M. FLAVIN




Sec. 33 T. 38s. R. 14 w.w.m.

RECEIVED

MAY 26 1995

WATER RESOURCES DEPT.
SALEM, OREGON

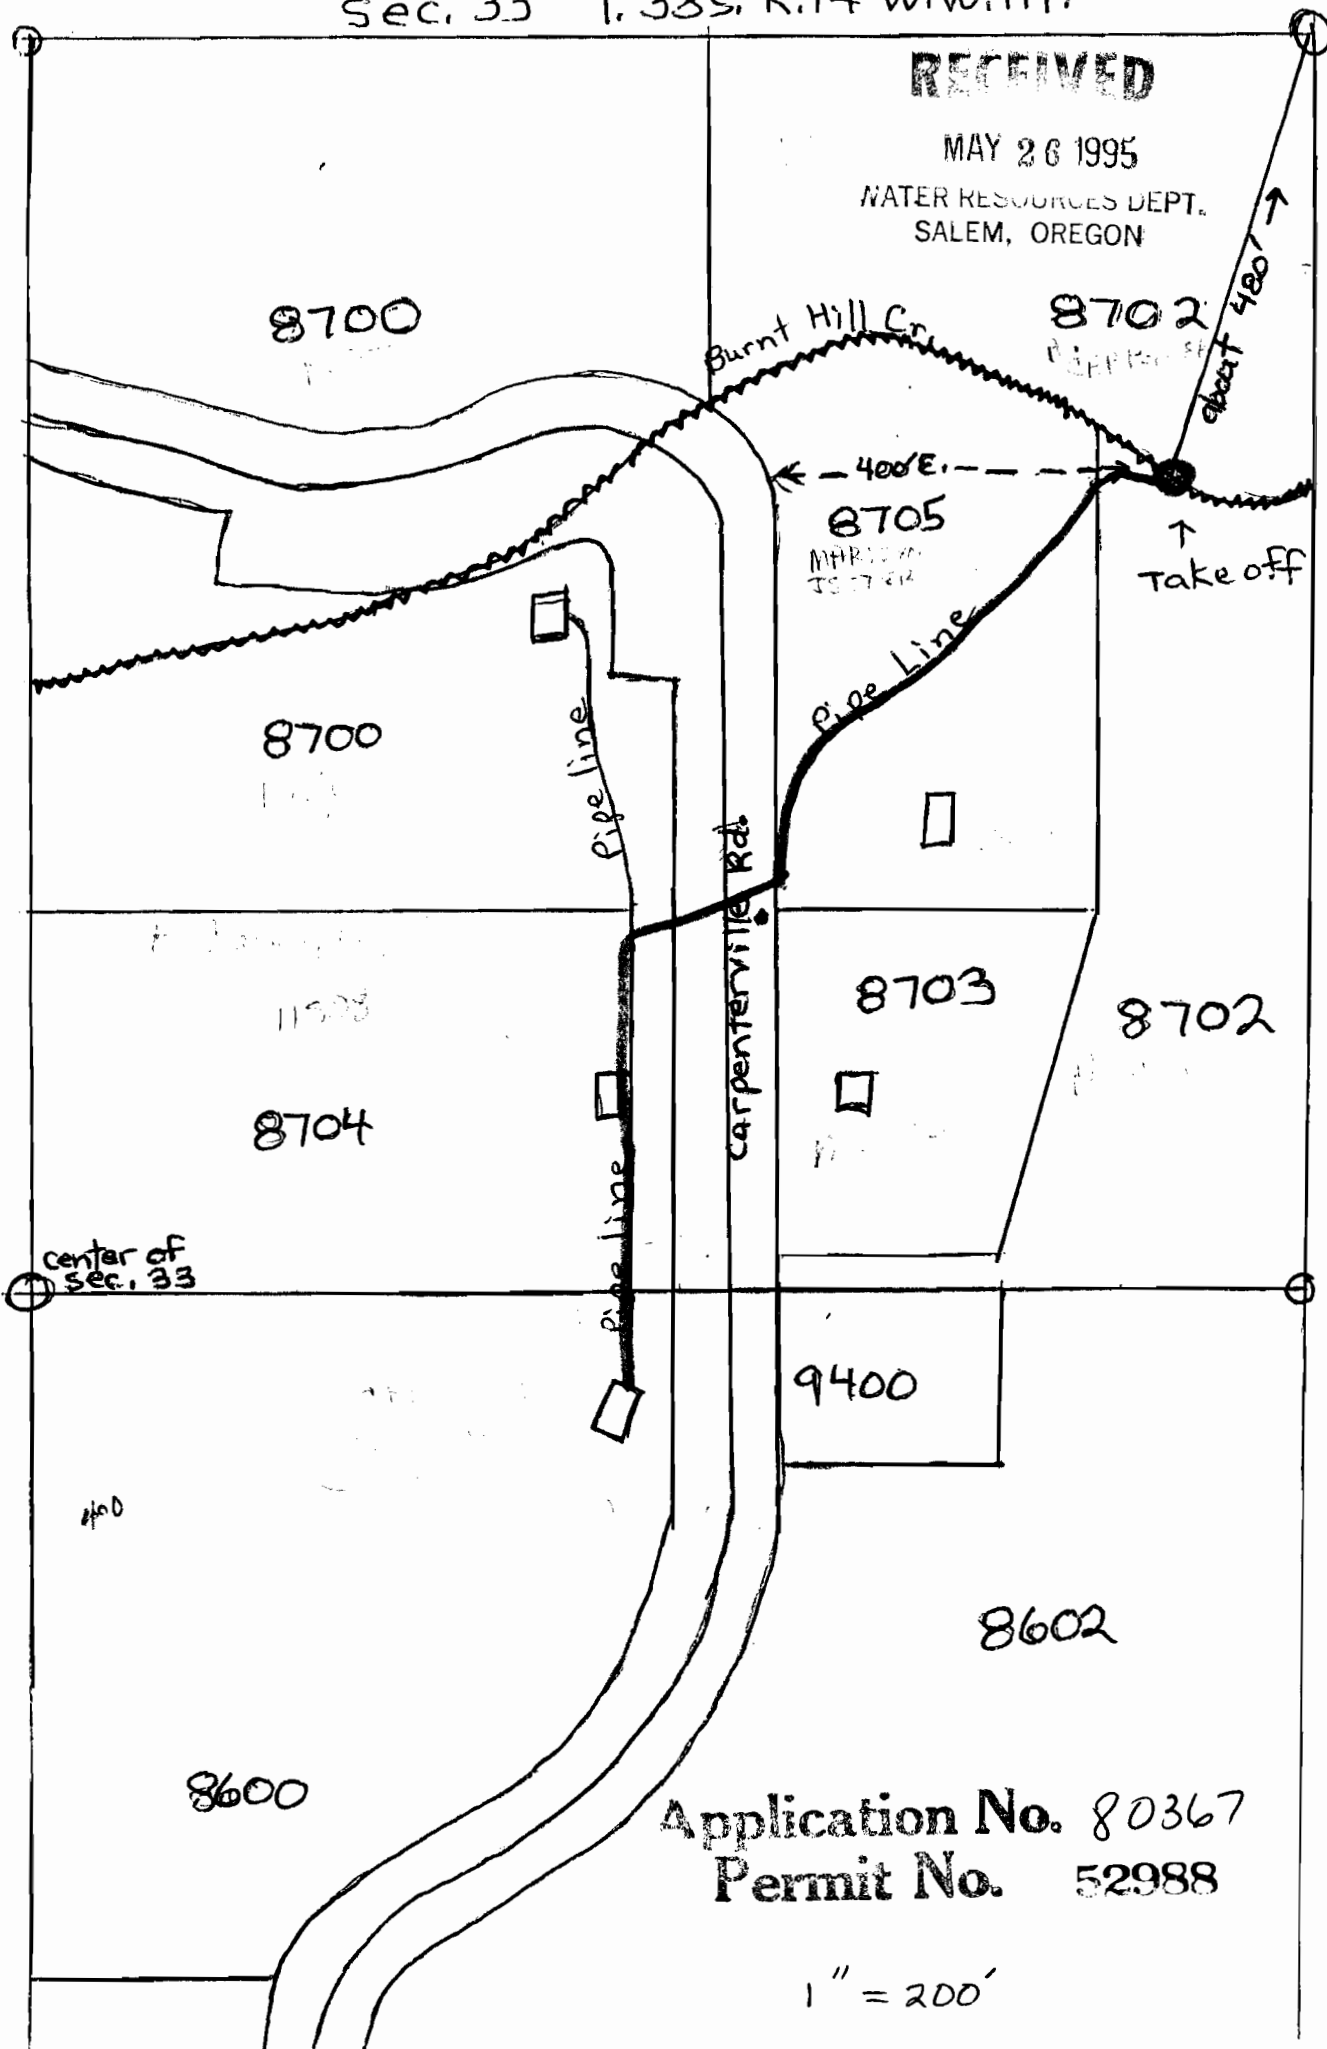

Application No. 80367
Permit No. 52988

1" = 200'