

SW1/4, SE1/4

SE1/4, SE1/4

28 27
33 34

NW1/4, NE1/4

NE1/4, NE1/4

CALC. FROM PROP. COR. TIES
NE COR. OF SW OF NE
SECTION 33

POINT OF DIVERSION
412 FEET SOUTH
142 FEET WEST
NE COR. OF SW OF NE
SECTION 33

BURNT HILL CREEK

SE1/4, NE1/4

SW1/4, NE1/4

THE PREPARATION OF THIS MAP WAS FOR THE PURPOSE OF IDENTIFYING
THE LOCATION OF THE PROPOSED WATER RIGHT AND HAS NO INTENT TO
PROVIDE DIMENSIONS OR LOCATION OF PROPERTY LINES.

FINAL PROOF SURVEY

APPLICATION S-80385

PERMIT #52985


IN THE NAME OF

PAUL & NELLIE SOUCY

SW 1/4, NE 1/4, SECTION 33

T. 38 S., R. 14 W., W. M.

SURVEYED OCTOBER 22, 1998 BY BRYAN M. FLAVIN

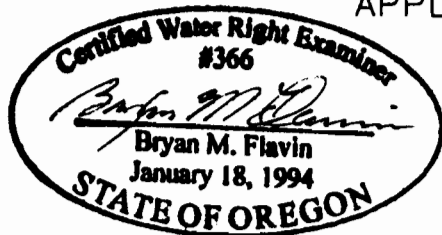

↑
N.

Sec. 33 T. 38s. R. 14 w. w. m.

Center Corn.
NE 1/4

MAY 30 1995

WATER
SALEM, OREGON

8700

8702

Burnt Hill Cr.

8705

8700

SWNE

Pipe Line

Carpenterville Rd.

8703

8702

8704

9400

8602

8600

Application No. 280385
Permit No. 52985

Paul R. Soney
5-24-96
SUPERSEDING
5/30/95

1" = 200'

