


T. 5 S. R. 1 W. W. M.

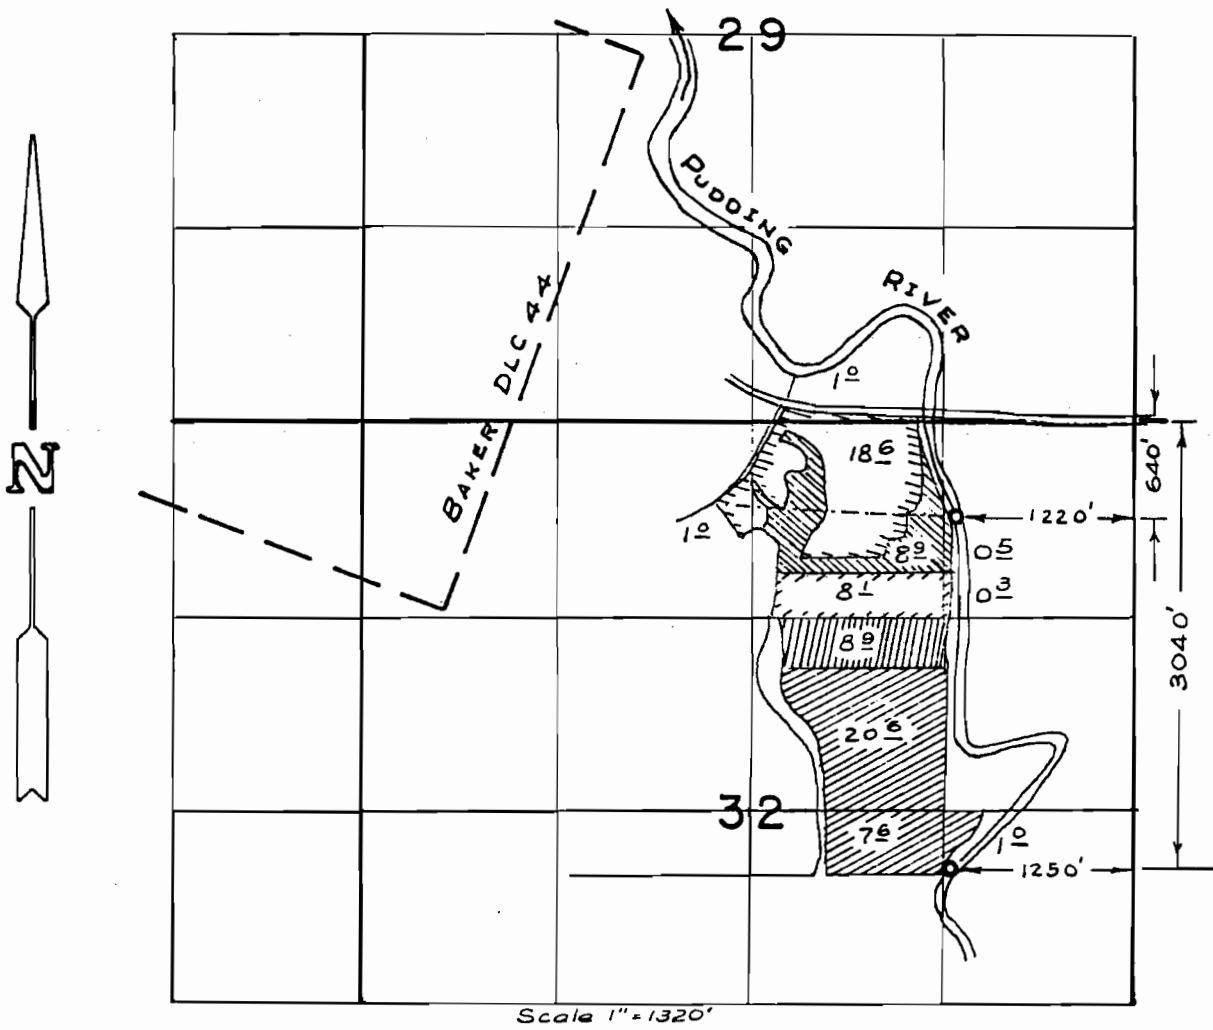

**Claim of Beneficial Use - Transfer T-6431
for
TRECO**

Permit 13084 Cert. No. 14423
 Permit 15399 Cert. No. 16879
 Permit 15399 Cert. No. 16877

Remaining

THE PREPARATION OF THIS MAP IS FOR THE
 PURPOSE OF IDENTIFYING THE LOCATION
 OF THE WATER RIGHT ONLY AND HAS NO
 INTENT TO PROVIDE DIMENSIONS OR LOCATION
 OF PROPERTY OWNERSHIP LINES.

