


T. 8 S. R. 4 W. W. M.

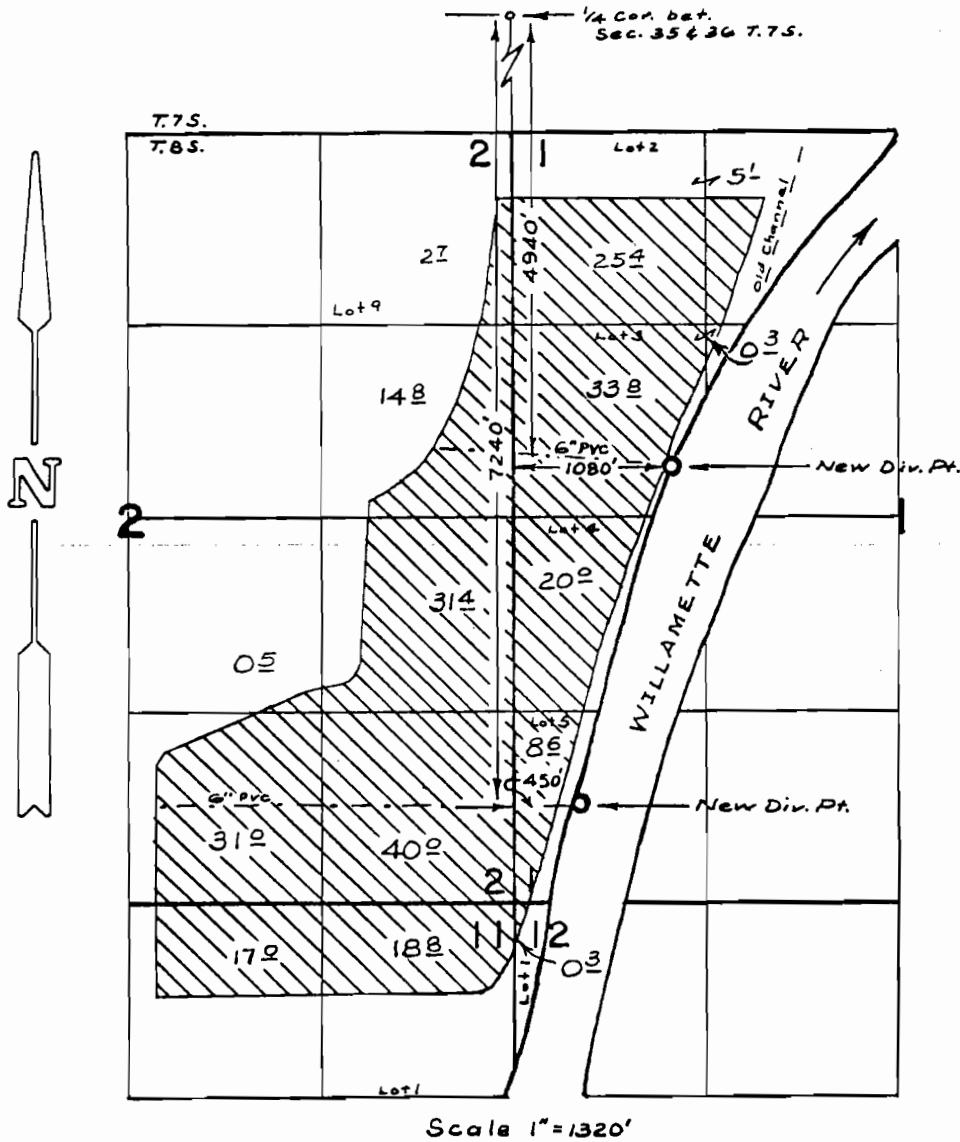

FINAL PROOF SURVEY
FOR
GREEN VILLA FARMS
TRANSFER No. T-6456
(PERMIT No. 29117)

THE PREPARATION OF THIS MAP IS FOR THE
PURPOSE OF IDENTIFYING THE LOCATION
OF THE WATER RIGHT ONLY AND HAS NO
INTENT TO PROVIDE DIMENSIONS OR LOCATION
OF PROPERTY OWNERSHIP LINES.

