


T. 3 S., R. 1 W., W.M.

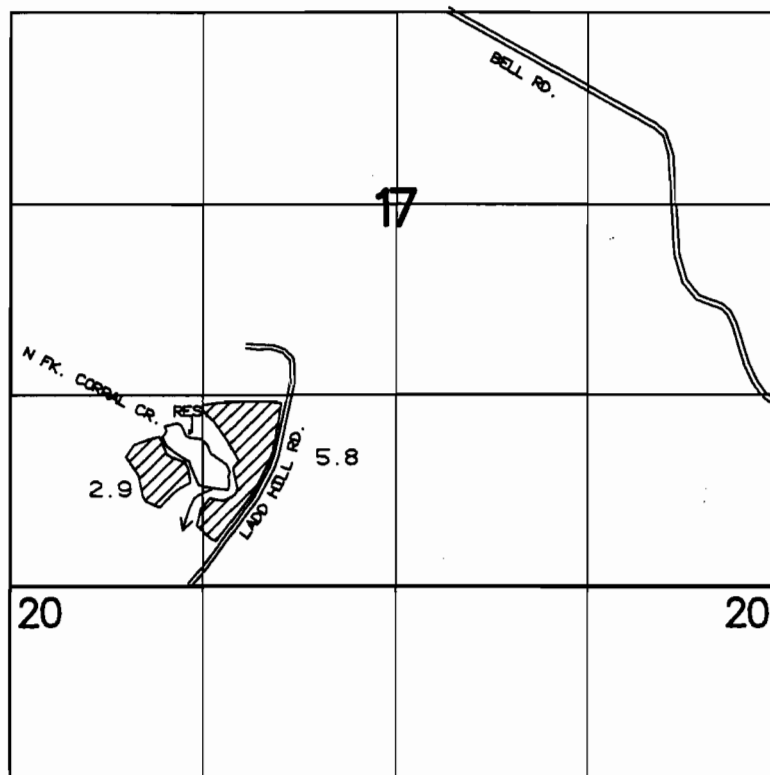

RESERVOIR LOCATION: 670 FT N AND 1400 FT
E FROM THE SW CORNER SECTION 17

FINAL PROOF SURVEY
UNDER

Application No.: R-65285 65286 Permit No.: R-8898 47911

IN THE NAME OF

DONALD K. LIVINGSTON

Surveyed: JULY 21, 1987

By: T. M. WARREN