



TOWNSHIP 9 SOUTH, RANGE 2 WEST, W.M.

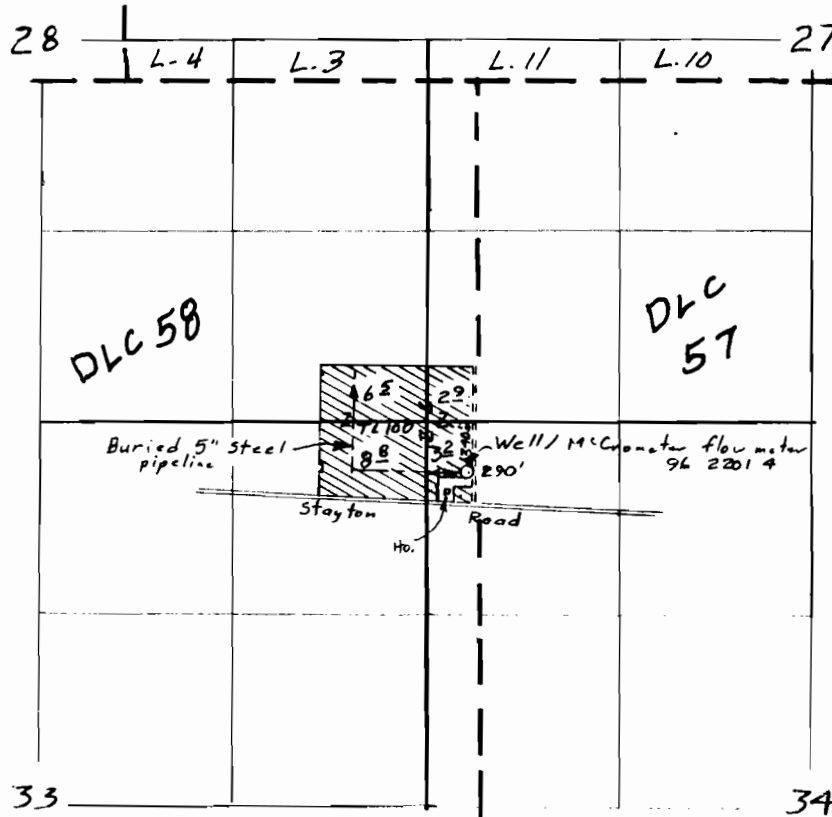

Scale 1" = 1320'

Surveyed Oct. 8, 1997

Claim of Beneficial Use Map
for
GAROLD & BONNIE MORRISSETTE

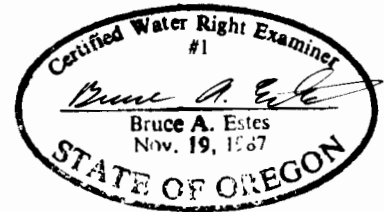

Application G-13803
Permit G-12130

RECEIVED

OCT 27 1997

WATER RESOURCES DEPT.
SALEM, OREGON

This map is for the purpose of
locating a water right only
and has no intent to provide
legal dimensions or the location
of property lines.

AMENDED 6/22/09 OWRD-LIV

ESTES SURVEYS

6293 Sunnyview Rd. NE 60382 Arnold Rd.
Salem, OR 97305 Bend, OR 97702
(503) 585-7593 (503) 382-7391