


T. 32S., R. 16E., W.M.

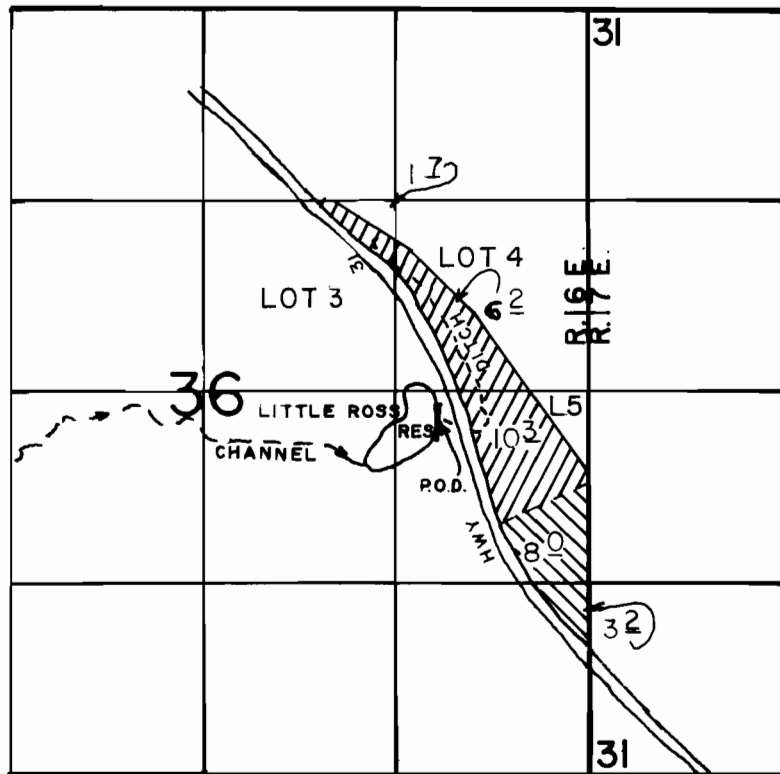

P.O.D. LOC: 2410' N & 1030' W FROM SE COR. OF SEC. 36.

SCALE: 1" = 1320'

FINAL PROOF SURVEY

UNDER

46498

34746

Application No. R-46497 Permit No. R-5543
IN NAME OF



PRIMARY



SUPPLEMENTAL

COLAHAN ENTERPRISES, INC.

Surveyed SEPT 8, 1994, by R.M. SUTTERFIELD

WRD 7-15-2010 gwg

PHOTO CHZ-2KK-45

11/2/94

R.M.S.