
T. 32S., R. 16E., W.M.

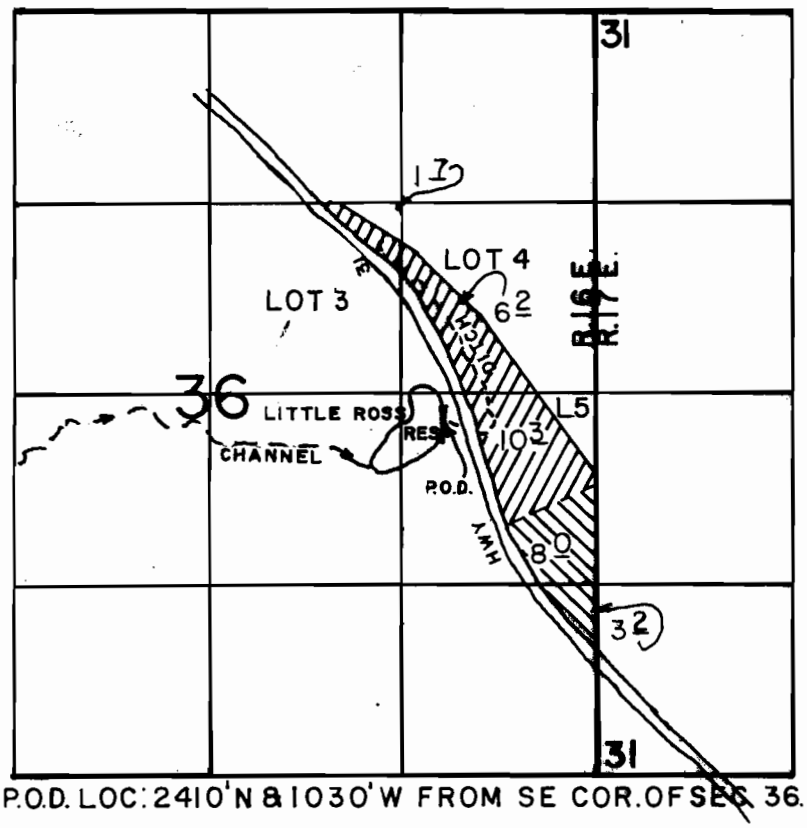

P.O.D. LOC: 2410'N & 1030'W FROM SE COR. OF SEC. 36.

SCALE: 1"=1320'

FINAL PROOF SURVEY

UNDER

46498 34746

Application No. R-46497 Permit No. R-5543

IN NAME OF

PRIMARY

SUPPLEMENTAL

COLAHAN ENTERPRISES, INC.

Surveyed SEPT 8, 1994, by R.M.SUTTERFIELD

PHOTO CHZ-2KK-45 11/2/94 R.M.S.