


T. 27 S., R. 34 E., W.M.

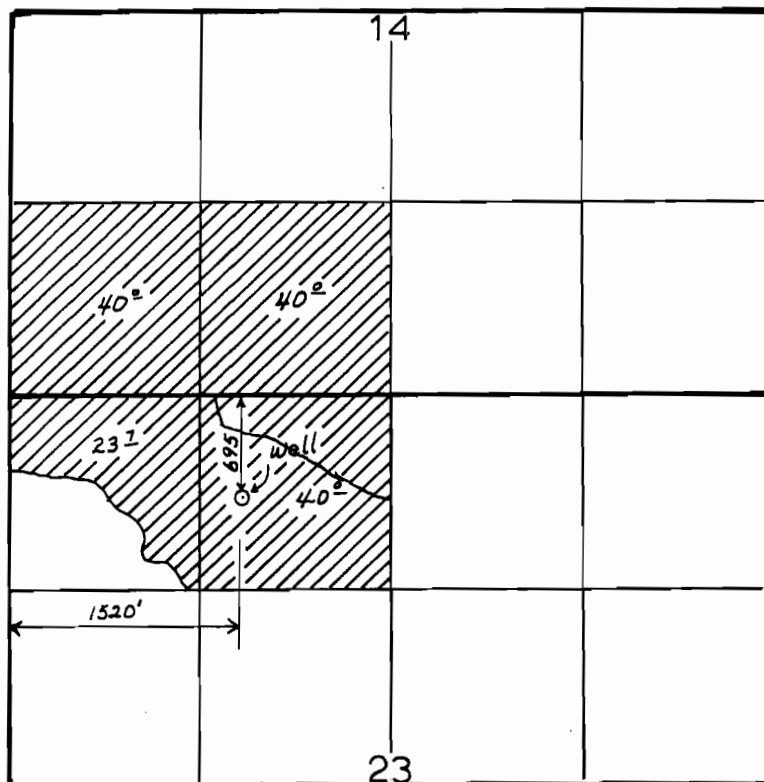

1" = 1320'

FINAL PROOF SURVEY

UNDER

Application No. G-9351 Permit No. G 8806

IN NAME OF

CAROLINE MANOCK
RUTH BEVERLY
BARBARA J. CANNADY

Surveyed 8/6, 1993, by J. MILLER