



T. 38 S., R. 4 W., W. M.

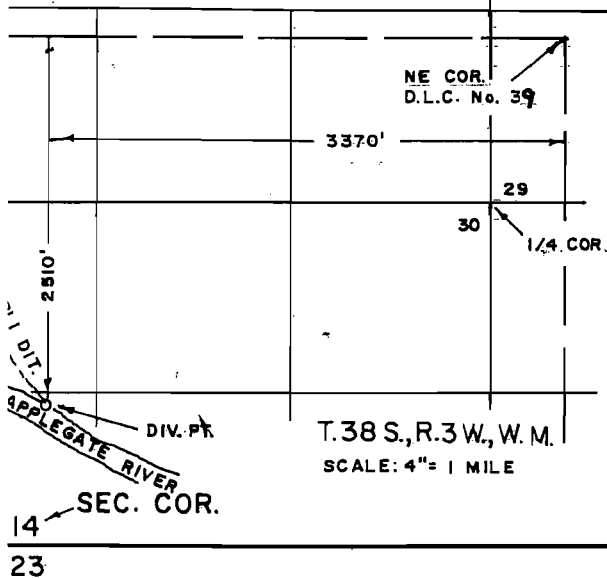

T. 38 S., R. 3 W., W. M.  
SCALE: 4" = 1 MILE

SE 1/4 SW 1/4

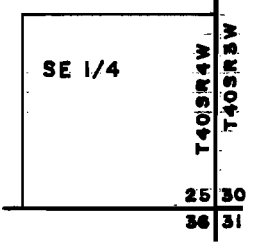


APPLEGATE LAKE RES.  
DIVERSION POINT

T. 40 S., R. 4 W., W. M.


SCALE: 2" = 1 MILE

007 18 1992

GOV'T LOT 1  
(NW 1/4 NW 1/4)

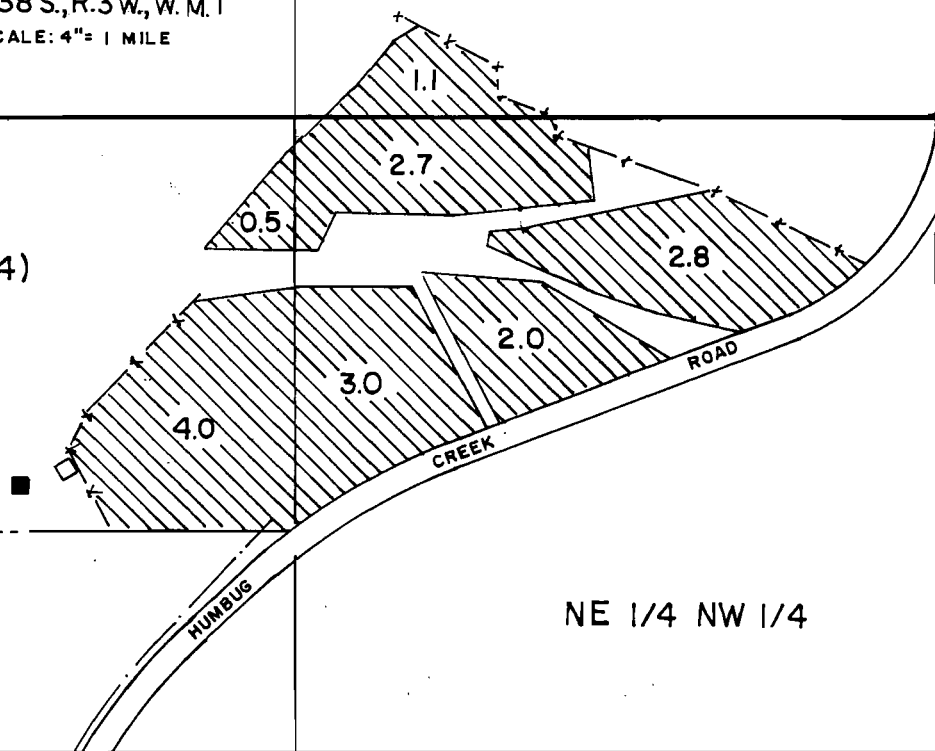

GOV'T LOT 2  
(SW 1/4 NW 1/4)

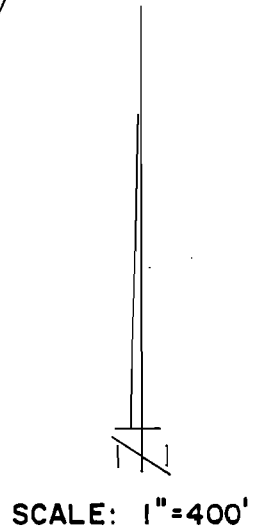

**FINAL PROOF MAP**

APPLICATION No. 69583 PERMIT No. 51072


IN THE NAME OF  
**FRED T. OWEN**

MAP PREPARED OCTOBER 7, 1992

BY GARY D. KAISER

REVISED 6-25-93. GDK

NOTE: THIS MAP HAS BEEN  
PREPARED FOR WATER RIGHT  
PURPOSES ONLY, NOT FOR  
PROPERTY BOUNDARY LOCATIONS.

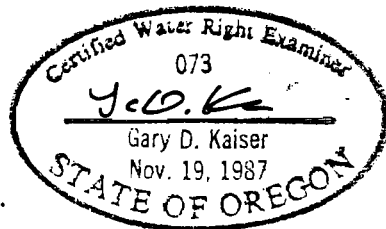

D.L.C. 38

PUMPING  
STATION

KUBI DIV.  
HWY.  
238