


T. 38 S., R. 4 W., W. M.

RECEIVED

OCT 19 1993

WATER RESOURCES DEPT.  
SALEM, OREGON

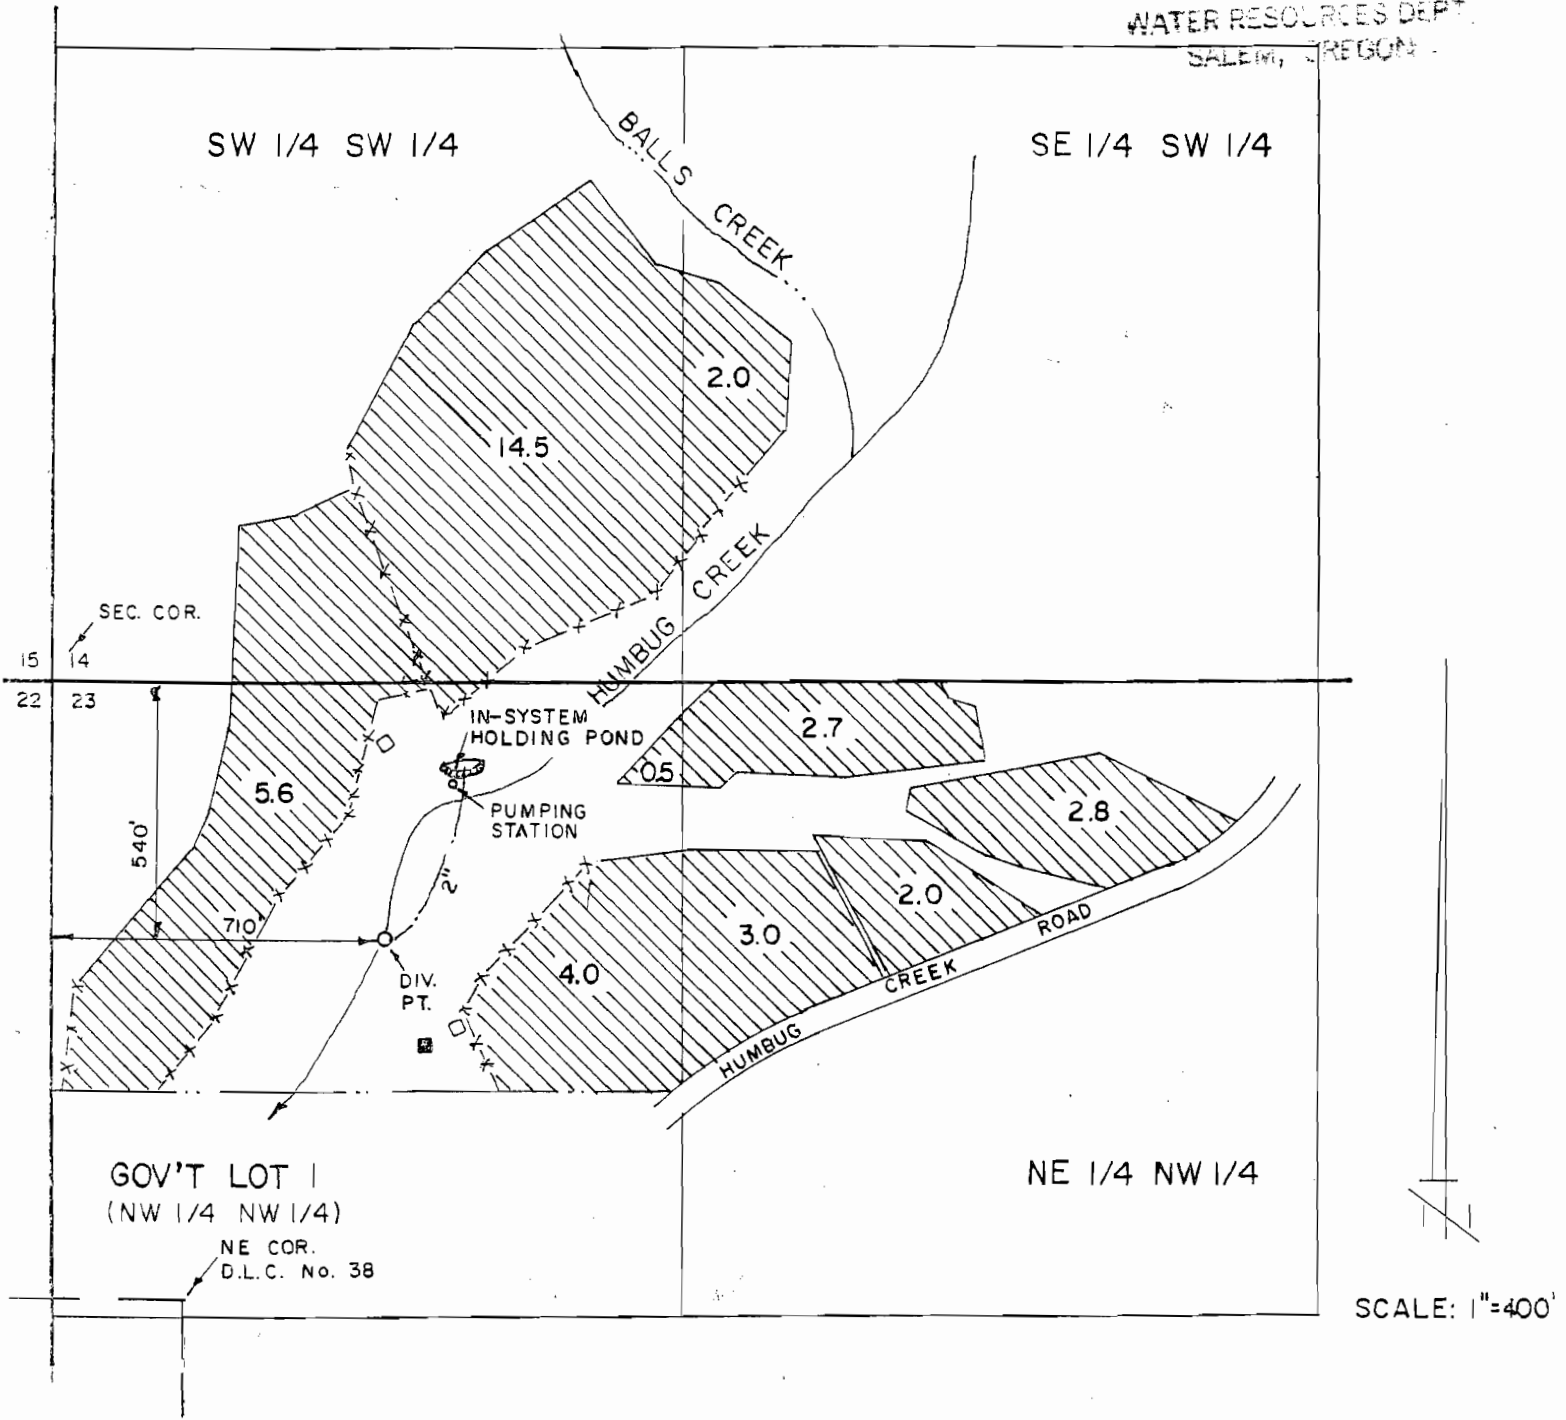

**FINAL PROOF MAP**

APPLICATION No. T-6452

**IN THE NAME OF  
FRED T. OWEN**

MAP PREPARED OCTOBER 13, 1993  
BY GARY D. KAISER

NOTE: THIS MAP HAS BEEN  
PREPARED FOR WATER RIGHT  
PURPOSES ONLY, NOT FOR  
PROPERTY BOUNDARY  
LOCATIONS.

