

T 39 S, R 3 W, W.M.
 Section 13
 Jackson County, Oregon


RECEIVED

FEB - 2 1998

WATER RESOURCES DEPT.
 SALEM, OREGON

Cl $\frac{1}{4}$ Cor.
 Fd. Brass Disc

13

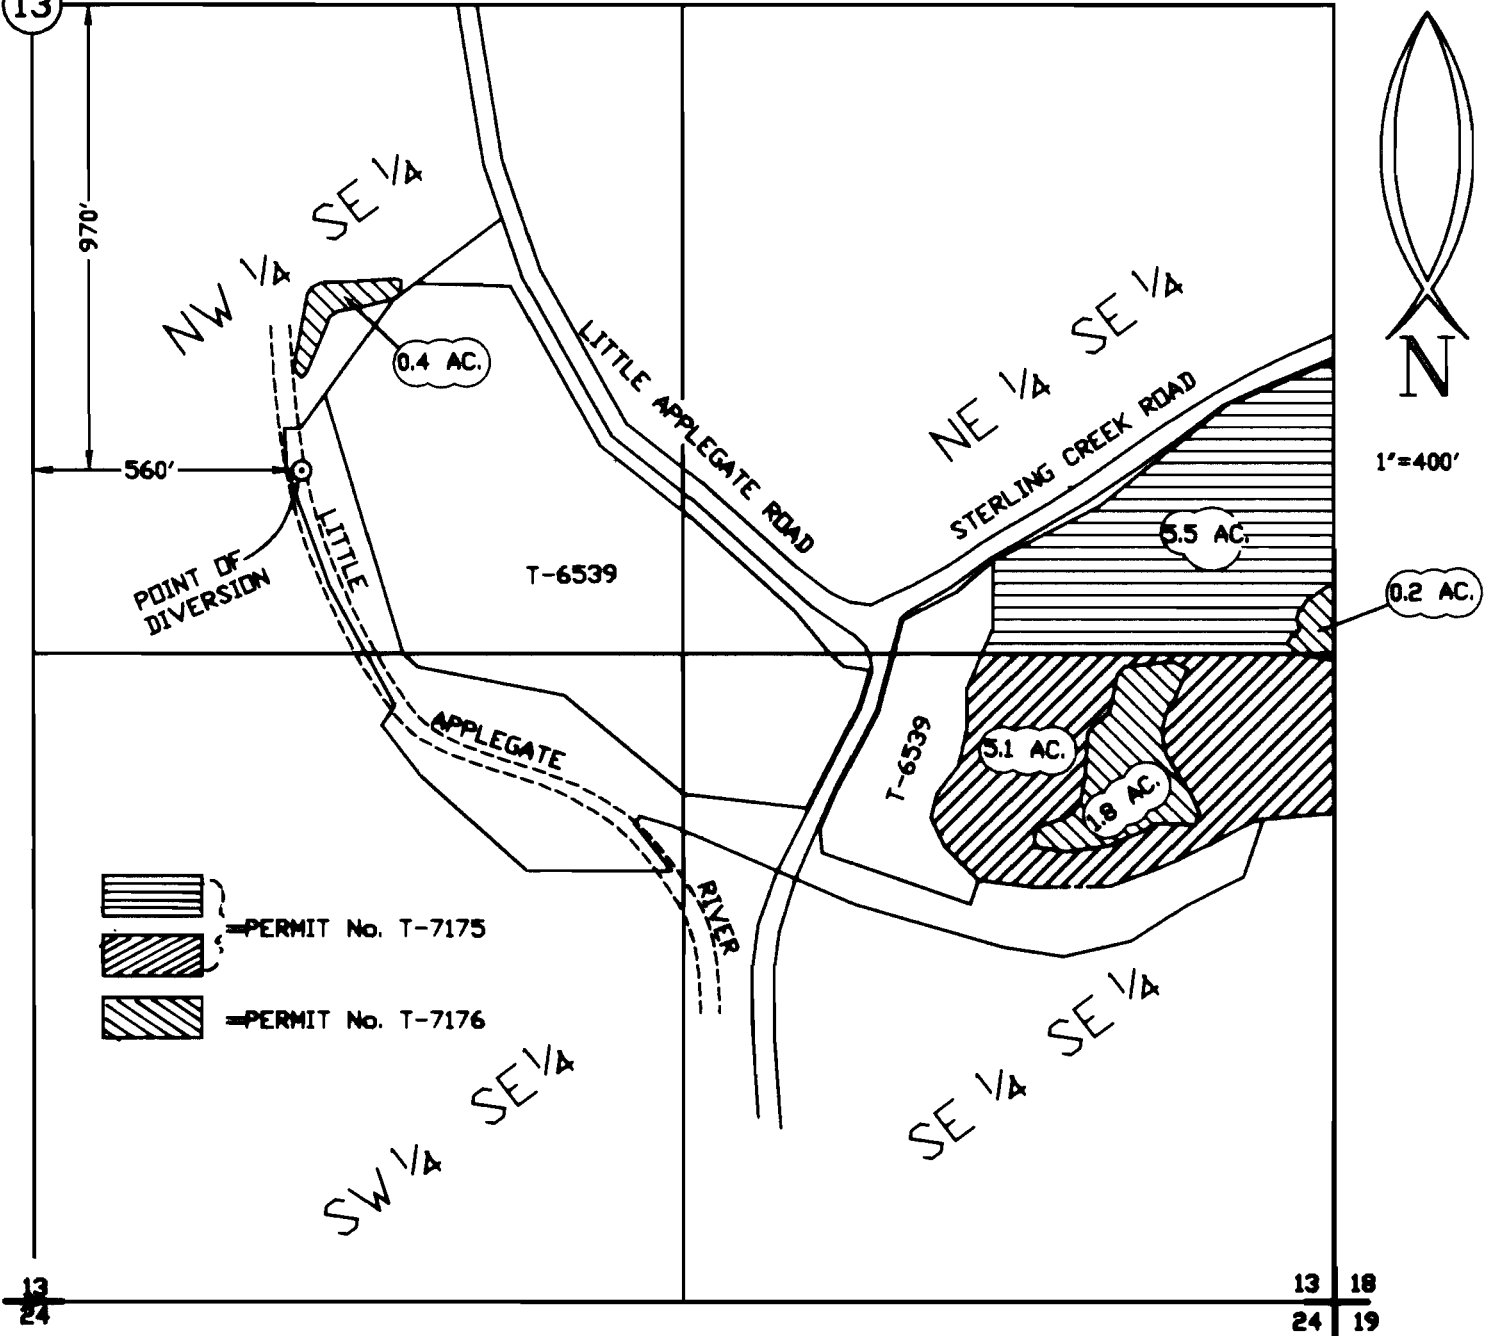

PERMIT No. T-7175
 PERMIT No. T-7176

FINAL PROOF SURVEY


UNDER

CHANGE IN POINT OF DIVERSION

Application No. T-7175 & T-7176

IN THE NAME OF

REEVE L. HENNION

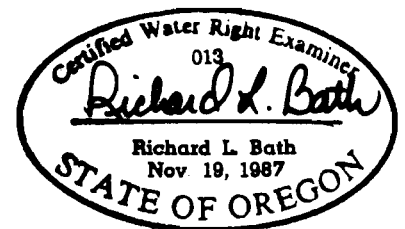

Surveyed SEPT. 12, 1997

By Richard L. Bath

Richard L. Bath
 CWRE No. 013