


T 39 S, R 3 W, W.M.
 Section 13
 Jackson County, Oregon

RECEIVED

FEB - 2 1998

WATER RESOURCES DEPT.
 SALEM, OREGON

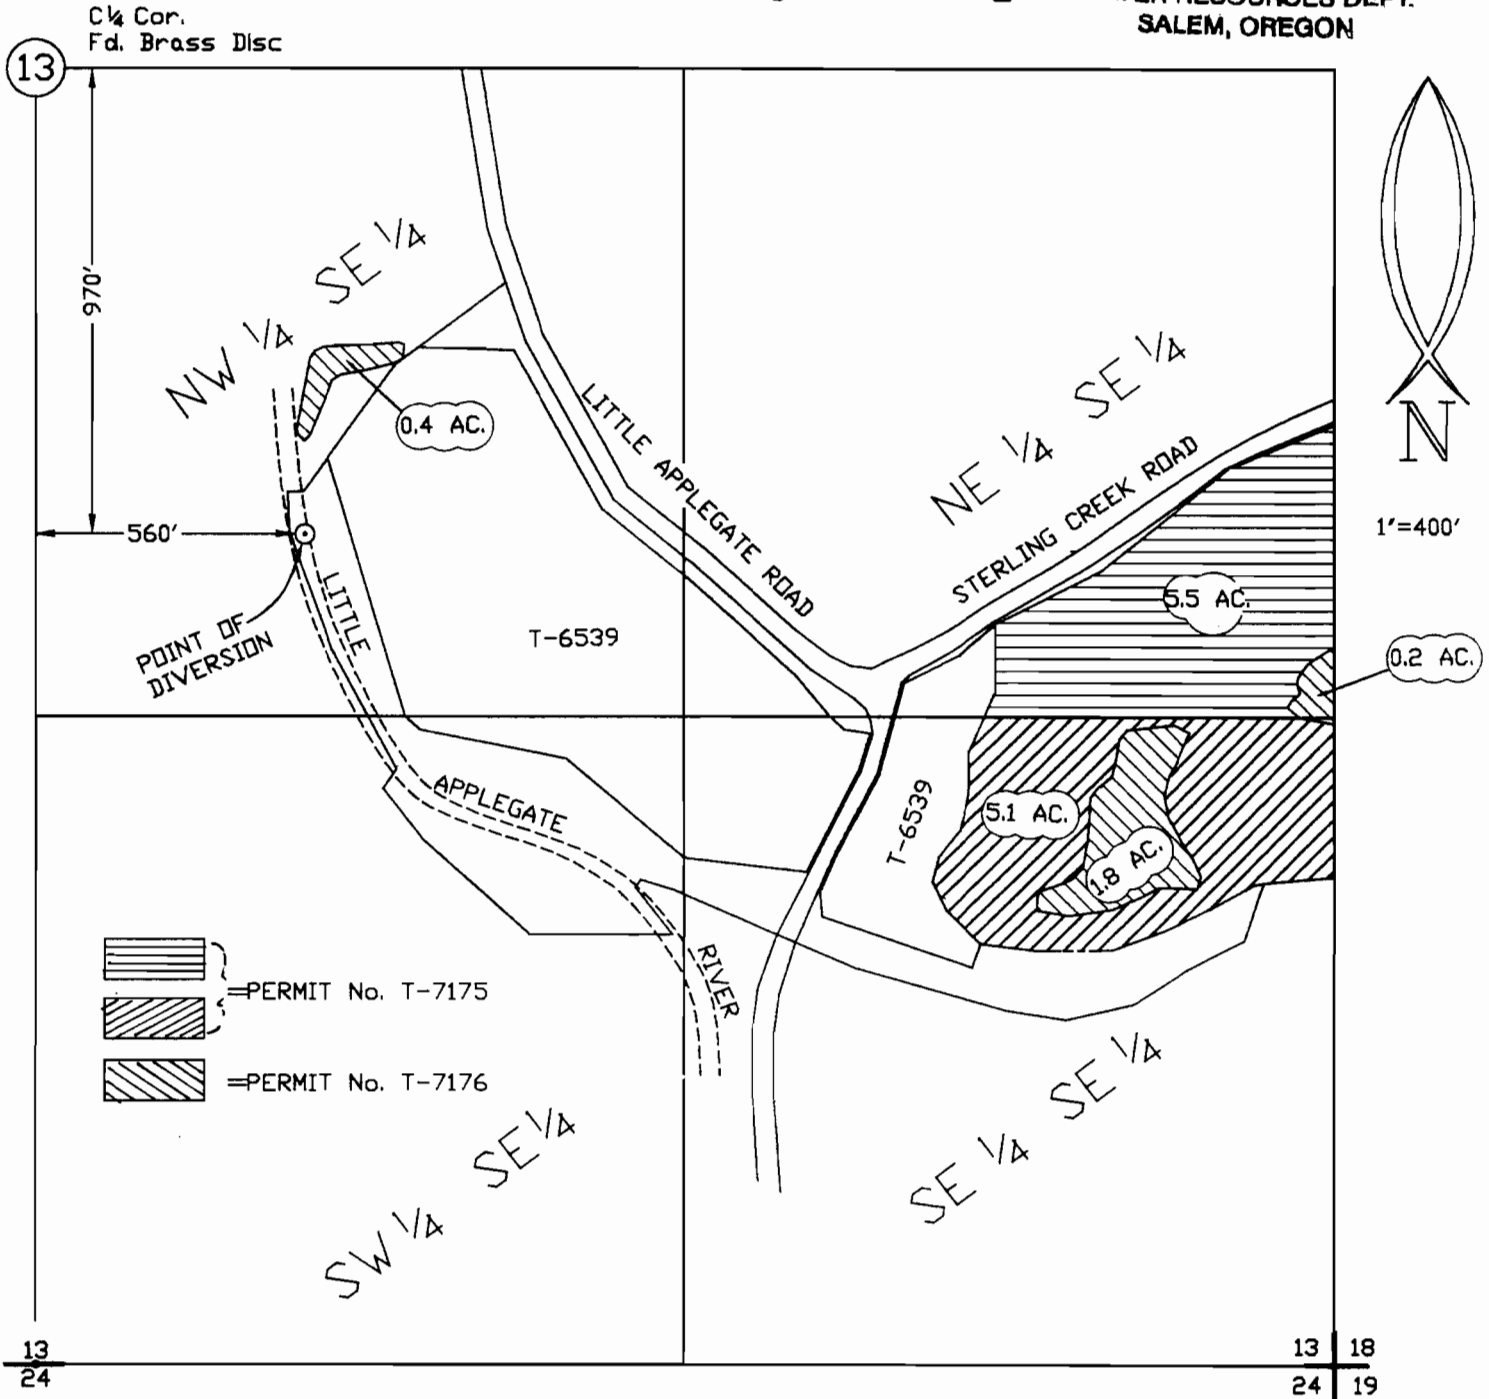

FINAL PROOF SURVEY


UNDER

CHANGE IN POINT OF DIVERSION

Application No. T-7175 & T-7176

IN THE NAME OF

REEVE L. HENNION

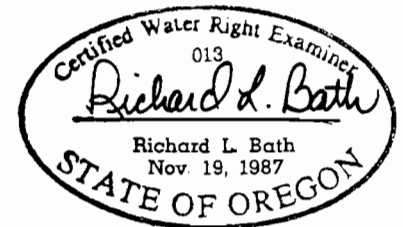

Surveyed SEPT. 12, 1997

By Richard L. Bath

Richard L. Bath
 CWRE No. 013

ORIGINAL IN