

RECEIVED

# FINAL PROOF SURVEY

MAY 18 1998

UNDER

Application No. T-6795 Permit No. C-160


WATER RESOURCES DEPT.  
SALEM, OREGON

IN NAME OF: Philip W. & Giannina Murphy  
HCR 79 Box 4  
Monument, OR 97864



Scale 1" = 400'

T9S R27E

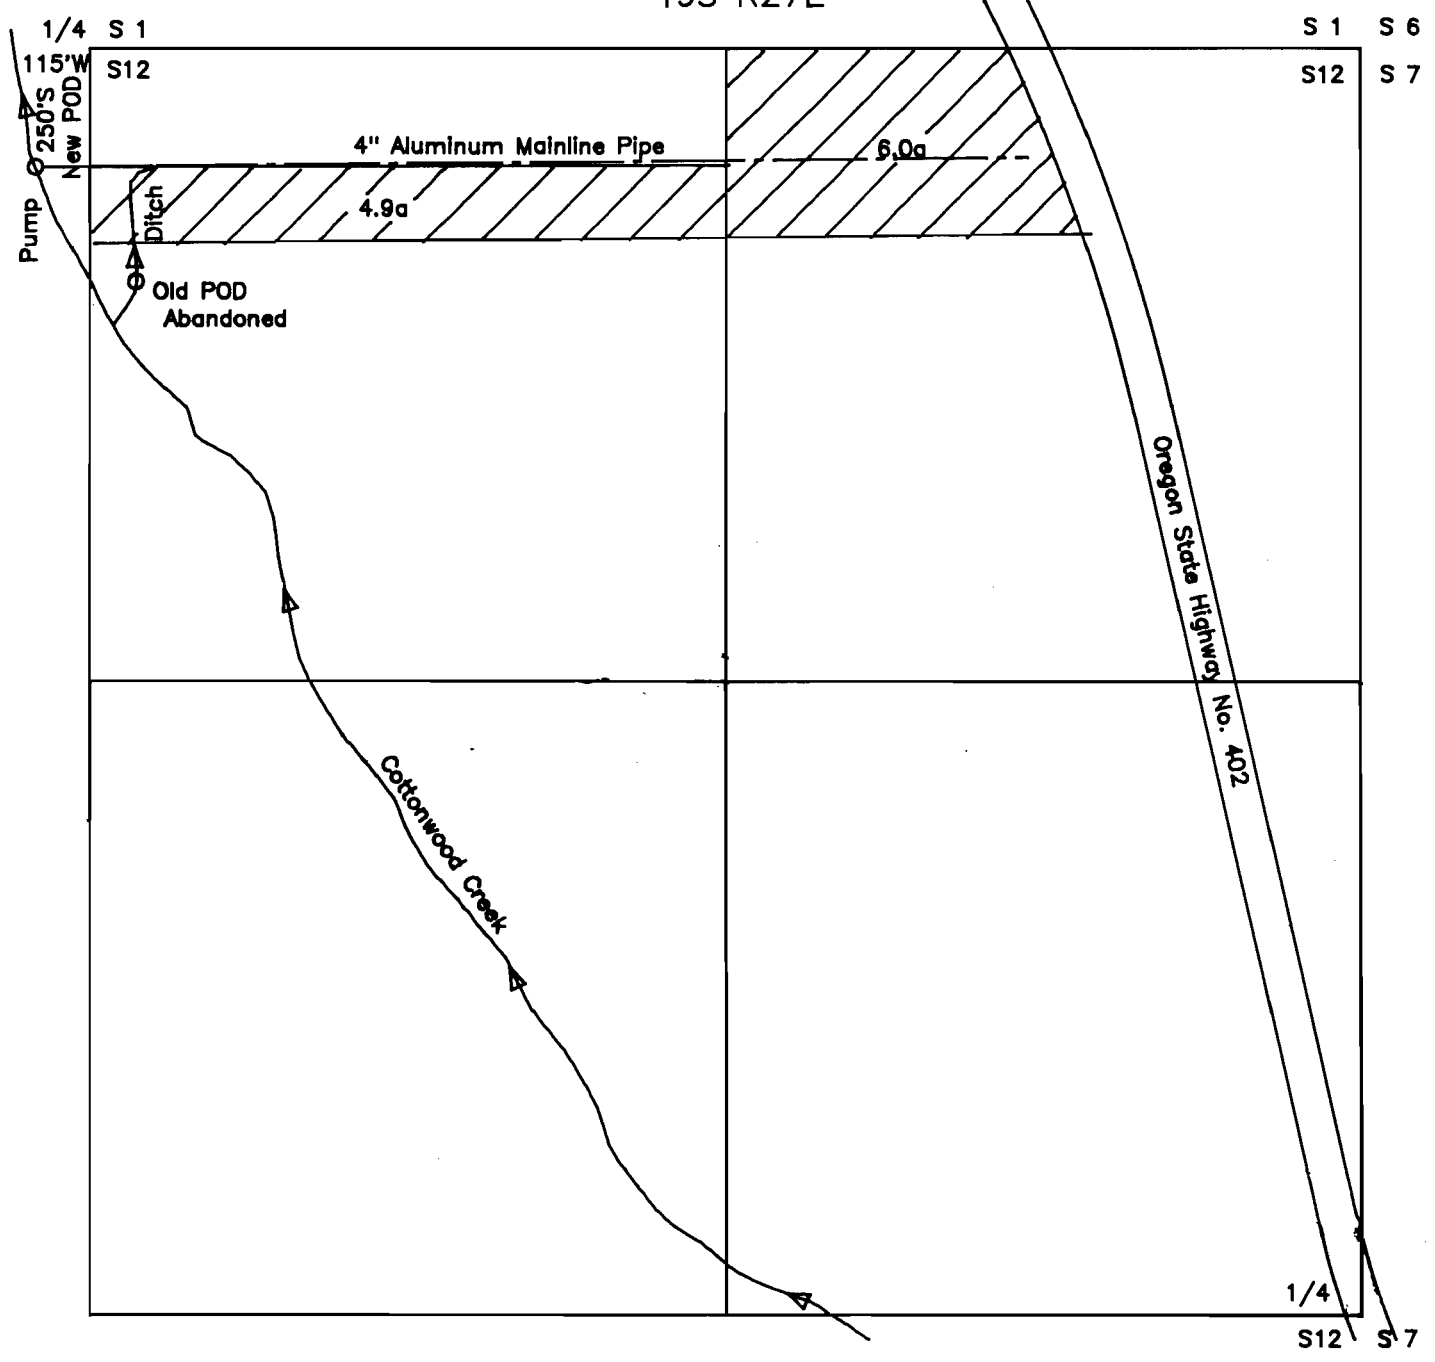

This map is for the purpose of identifying the location of the water right only and has no intent to provide dimensions or location of property ownership lines.