

FINAL PROOF MAP
 FOR
 CHANGE IN POINT OF DIVERSION
 FOR ROBERT DUNCALF
 LOCATED IN SECTIONS 8 AND 9,


RECEIVED

JUN - 3 1998

WATER RESOURCES DEPT.
 SALEM, OREGON

T.1S. R.3W. W.M.
 WASHINGTON COUNTY, OREGON.
 MAY 8, 1998

APPLICATION No. T-6958

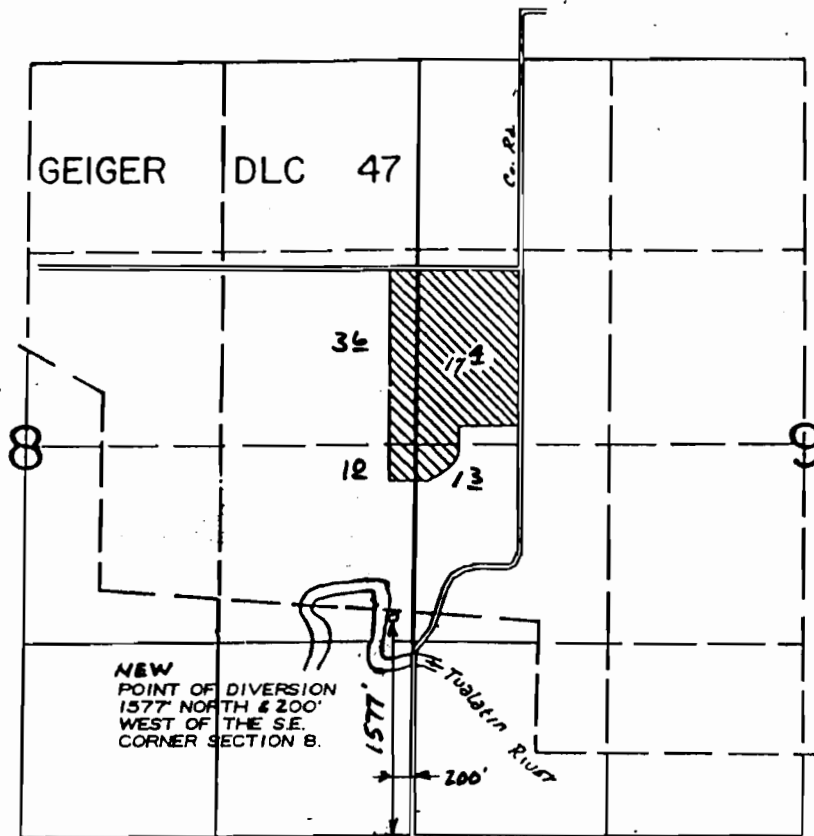

NEW
 POINT OF DIVERSION
 1577' NORTH & 200'
 WEST OF THE S.E.
 CORNER SECTION 8.

THIS MAP DOES NOT INTEND TO PROVIDE
 DIMENSIONS FOR THE EXACT LOCATION
 OF PROPERTY OR BOUNDARY LINES.

CHARLES E. SPEAR CWRE No. 187
 831 N.E. BIRCHAIRE LANE
 HILLSBORO, OREGON 97124

